


MAP SHEET


TOWN 31 N RANGE 1 E

DATE	FILE NO.
DIVISION	DISTRICT
MAPPED BY:	
PHOTO NUMBERS	

COUNTY	TOWNSHIP	NUMBER OF ACRES
<u>Montmorency</u>		
OWNER OF LAND		
PURPOSE OF MAP		

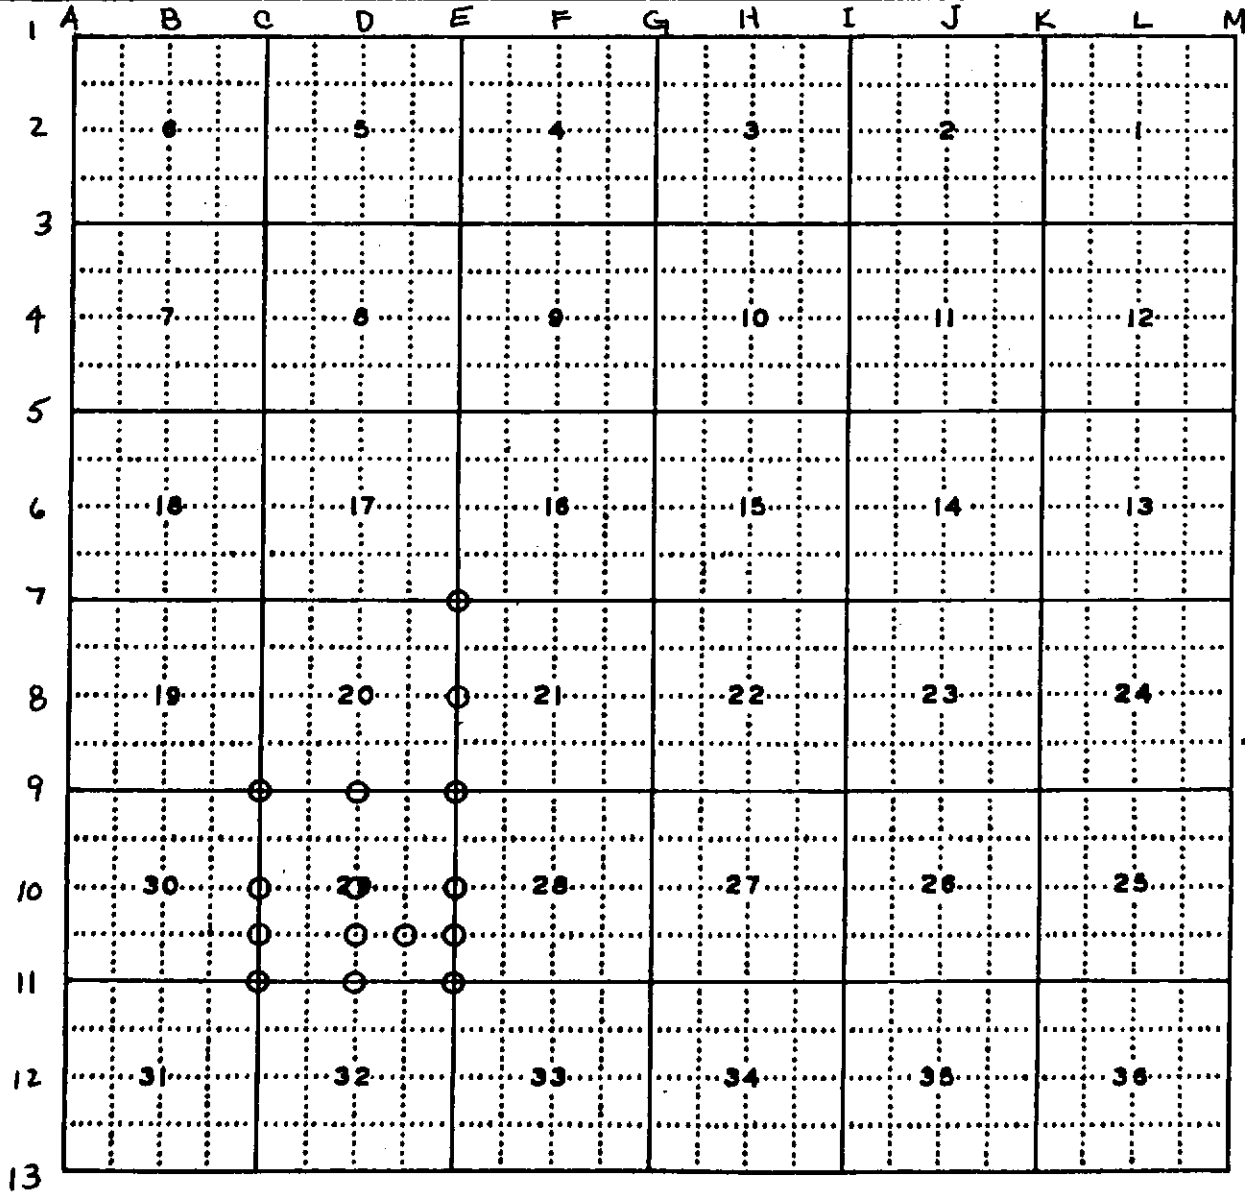

REMARKS

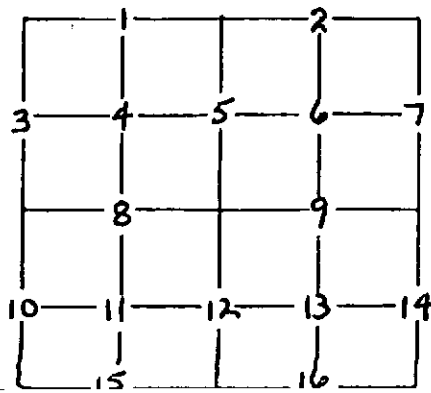

- denotes 2 records