

STATE OF MICHIGAN
DEPARTMENT
OF
NATURAL RESOURCES

LAND CORNER RECORD


MONTMORENCY COUNTY
T 31 N R 1 E

DESCRIPTION OF CORNER N 1/4 corner

CORNER MONUMENT Set DNR Monument

DATE MONUMENT PLACED AND WITNESSED 9-8-72

WITNESSES TO CORNER.....

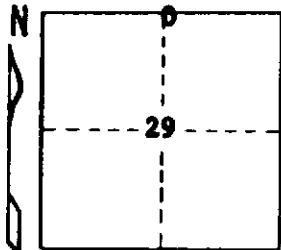

Twin 5" W. Birch N 72 E 24.1'


16" Poplar N 27 E 27.15'

AND

CIRCLE CORNER REGISTERED

DESCRIPTION IN DETAIL AS TO HOW CORNER WAS LOCATED AND IDENTIFIED OR RESTORED.

Corner set at the calculated midpoint on line between section corners. Unable to locate any evidence of a previous corner.

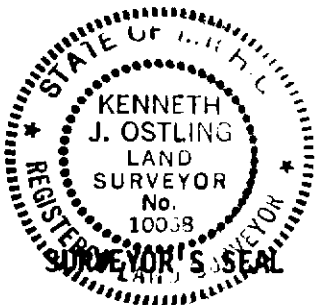

SIGNED Kenneth J. Ostling DATE 9-12-72
REGISTERED LAND SURVEYOR 10038

DISTRIBUTION:

Forestry Division, Lansing