

✓

STATE OF MICHIGAN  
DEPARTMENT  
OF  
NATURAL RESOURCES

LAND CORNER RECORD


MONTMORENCY COUNTY  
T 31 N R I E

DESCRIPTION OF CORNER Center Post, Section 29

CORNER MONUMENT Set 2' of 1" pipe

DATE MONUMENT PLACED AND WITNESSED 9-8-72

WITNESSES TO CORNER..... \_\_\_\_\_

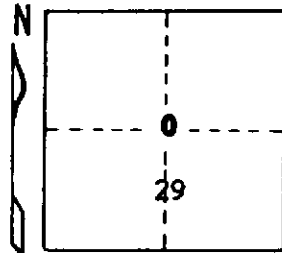

7" Maple (in clump) S 79 W 48.2'

7" W. Birch N 50 E 73.1'


AND

Falls 61' North of Ctr. Line old R.R. Grade

CIRCLE CORNER REGISTERED

DESCRIPTION IN DETAIL AS TO HOW CORNER WAS LOCATED AND IDENTIFIED OR RESTORED.

Corner set at calculated intersection of true 1/4 lines, per standard survey procedure.

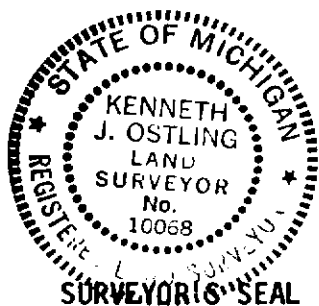

DISTRIBUTION:

Forestry Division, Lansing

\_\_\_\_\_

\_\_\_\_\_

SIGNED Kenneth J. Ostling DATE 9-12-72  
REGISTERED LAND SURVEYOR

10068