

STATE OF MICHIGAN  
DEPARTMENT  
OF  
NATURAL RESOURCES

LAND CORNER RECORD


MONTMORENCY COUNTY  
T 31 N R 1 E

DESCRIPTION OF CORNER West 1/4 corner

CORNER MONUMENT Set DNR Monument

DATE MONUMENT PLACED AND WITNESSED 9-11-72

WITNESSES TO CORNER.....

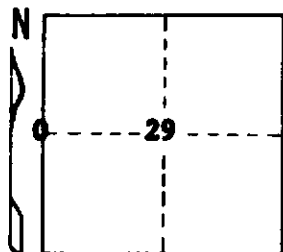

5" Cedar N 19 E 73.4'

15" R. Oak S 82 W 48.7'


AND

CIRCLE CORNER REGISTERED

DESCRIPTION IN DETAIL AS TO HOW CORNER WAS LOCATED AND IDENTIFIED OR RESTORED.

Found 1" iron Rod & Small piece of R.R. Rail in place.

Falls on line between section corners, by calculation, obviously placed by survey procedure.

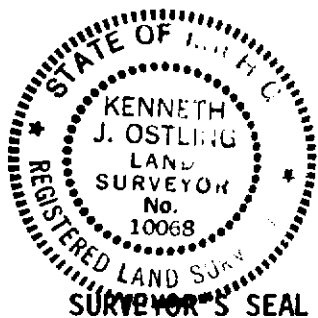

SIGNED Kenneth J. Ostling DATE 9-13-72

REGISTERED LAND SURVEYOR

10068

DISTRIBUTION:

Forestry Division, Lansing