

LAND CORNER RECORDATION CERTIFICATE
Filing Requirement of Act 74, Mich. P.A. 1970

For corners in

<u>Montmorency</u> <small>(County)</small>	Located In:	Corner Code <u>##</u>
1. Public Land Survey	T <u>31</u> N R <u>1E</u>	<u>G-12</u>
	T <u>31</u> N R <u>1E</u>	<u>H-11</u>
	T _____ R _____	_____
	T _____ R _____	_____
2. Property Controlling in Section	S <u>34</u> T <u>31</u> N R <u>1E</u>	<u>7</u>
	S _____ T _____ R _____	_____
3. Miscellaneous Property in Sec.	S _____ T _____ R _____	_____
	S _____ T _____ R _____	_____

Register of Deeds Stamp & File Number

4. Lot No. _____, Recorded Plat _____
 5. Private Claims _____

#2 - June 23,

I, Carl R. Johnson, in a field survey on June 18, 19 86, do hereby certify that under requirements of P.A. 74, Michigan P.A. of 1970, the corner points mentioned in lines 1 and 2 above were in conformance with regulations and rules therefore as required in the current manual of survey instructions of the United States Department of the Interior, Bureau of Land Management or by a decree of a Court of Law and/or that the corner points mentioned in lines 3, 4 and 5 above were in conformance with the rules of the Michigan Board of Land Surveyors or by a Decree of a Court of Law; established, re-established, monumented, re-monumented, recovered, found as expressed below:

NOTE: Not more than 4 corners, all in the same town and range, may be recorded on this certificate.

	A	B	C	D	E	F	G	H	I	J	K	L	M
2	6		5		4		3		2		1		
3													
4	7		8		9		10		11		12		
5													
6	15		17		16		15		14		13		
7													
8	19		20		21		22		23		24		
9													
10	30		29		28		27		26		25		
11													
12	31		32		33		34		35		36		
13													

A. Description of original monument and accessories and/or subsequent restoration:

B. Description of corner evidence found and/or method applied in restoring or reestablishing corner:

G-12 - Set midway and on line between section corners. No evidence of original or subsequent survey.

H-11 - Set midway and on line between section corners. No evidence of original or subsequent survey.

7 - Set by standard survey procedure for subdivision of a section.


C. Description of monument for corner and accessories established to perpetuate locating the position of the corner:

G-12 - W 1/4 Cor. Sec. 34
 Set DNR Mon. & cedar post
 10" Oak N68°W 55.9'
 3" Cherry S81°E 26.2'

H-11 - N 1/4 Cor. Sec. 34
 Set DNR Mon. & cedar post
 7" Maple N36°E 6.0'
 6" Cedar S88°E 18.0'
 6" Maple S 8°W 31.1'

7 - N 1/8 on E side
 Set 5/8" bar w/cap & cedar post
 16" Basswood N75°E 97.8'
 6" Aspen N30°W 142.0'

Signed by Carl R. Johnson
 Surveyor's Michigan License No. 30083

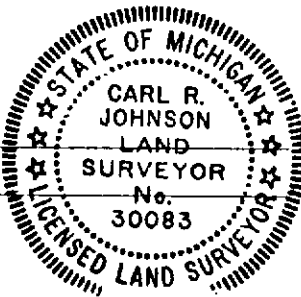

Date 10/24/82