

LAND CORNER RECORDATION CERTIFICATE
Filing Requirement of Act 74, Mich. P.A. 1970

For corners in
Montmorency
(County)

Located In: _____ Corner Code # _____

- | | | |
|------------------------------------|--------------------------|-------------|
| 1. Public Land Survey | T <u>31N</u> R <u>1E</u> | <u>I-13</u> |
| | T <u>31N</u> R <u>1E</u> | <u>H-13</u> |
| | T <u>31N</u> R <u>1E</u> | <u>I-11</u> |
| | T <u>31N</u> R <u>1E</u> | <u>I-12</u> |
| 2. Property Controlling in Section | S _____ T _____ R _____ | _____ |
| | S _____ T _____ R _____ | _____ |
| 3. Miscellaneous Property in Sec. | S _____ T _____ R _____ | _____ |
| | S _____ T _____ R _____ | _____ |

Register of Deeds Stamp & File Number

4. Lot No. _____, Recorded Plat _____
5. Private Claims _____

	A	B	C	D	E	F	G	H	I	J	K	L	M
2	6	5	4	3	2	1							
3													
4	7	8	9	10	11	12							
5													
6	18	17	16	15	14	13							
7													
8	19	20	21	22	23	24							
9													
10	30	29	28	27	26	25							
11													
12	31	32	33	34	35	36							
13													

I, Carl R. Johnson, in a field survey on June 4, 19 86, do hereby certify that under requirements of P.A. 74, Michigan P.A. of 1970, the corner points mentioned in lines 1 and 2 above were in conformance with regulations and rules therefore as required in the current manual of survey instructions of the United States Department of the Interior, Bureau of Land Management or by a decree of a Court of Law and/or that the corner points mentioned in lines 3, 4 and 5 above were in conformance with the rules of the Michigan Board of Land Surveyors or by a Decree of a Court of Law; established, re-established, monumented, re-monumented, recovered, found as expressed below:

NOTE: Not more than 4 corners, all in the same town and range, may be recorded on this certificate.

A. Description of original monument and accessories and/or subsequent restoration:

B. Description of corner evidence found and/or method applied in restoring or reestablishing corner:

I-13 - Set by single proportion between found SW corner section 34 and south $\frac{1}{2}$ corner section 35. No evidence of original or subsequent survey.

H-13 - Set midway and on line between section corners. No evidence of original or subsequent survey.

I-11 - Witnessed found re-established corner by Carl Robinson, Land Surveyor.

I-12 - Set midway and on line between section corners. No evidence of original or subsequent survey.

C. Description of monument for corner and accessories established to perpetuate locating the position of the corner:

I-13 - SE corner Sec. 34
 Set DNR Mon. & cedar post
 6" Spruce N88°W 8.3'
 6" Spruce N69°E 7.3'


H-13 - S $\frac{1}{2}$ Cor. Sec. 34
 Set DNR Mon. & cedar post
 12" Cedar N72°E 30.5'
 14" Cedar N84°W 18.0'

I-11 - NE Cor. Sec. 34
 FD $\frac{1}{2}$ " bar in Conc., set cedar post
 7" Maple S54°W 8.9'
 5" Maple N64°E 8.2'

I-12 - E $\frac{1}{2}$ Cor. Sec. 34
 Set DNR Mon. & cedar post
 16" Basswood S24°E 45.6'
 7" Maple N27°E 125.0'

Signed by Carl R. Johnson

Surveyor's Michigan License No. 30083

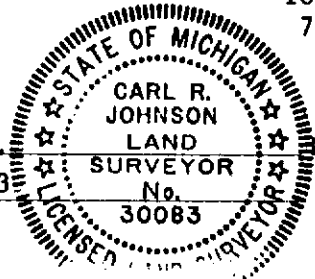

Date 10/20/86