

APR 24 1995

LAND CORNER RECORDATION CERTIFICATE
Filing Requirement of Act 74, Mich. P.A. 1970

For corners in COMMISSION

Montmorency (County)

Located In: Vienna Twp Corner Code #

STATE OF MICHIGAN
MONTMORENCY COUNTY
Recorded & Filed

11-02-1994 15:45:39

A. PANGAN-MCELROY
REGISTER OF DEEDS

- 1. Public Land Survey T 31 N R 1 E (A-7)
- 2. Property Controlling S T R
- in Section S T R
- 3. Miscellaneous S T R
- Property in Sec. S T R

APPROVED BY
PEER GROUP

MAY 13 1994

Register of Deeds Stamp & File Number

- 4. Lot No. _____, Recorded Plat _____
- 5. Private Claims _____

	A	B	C	D	E	F	G	H	I	J	K	L
2	8	5	4	3	2	1						
3												
4	7	6	9	10	11	12						
5												
6	16	17	16	15	14	13						
7												
8	19	20	21	22	23	24						
9												
10	30	29	28	27	26	25						
11												
12	31	32	33	34	35	36						
13												

Larry G. Beauregard in a field survey on August, 19 94, do hereby certify that under requirements of P.A. 74, Michigan P.A. of 1970, the corner points mentioned in lines 1 and 2 above were in conformance with regulations and rules therefore as required in the current manual of survey instructions of the United States Department of the Interior, Bureau of Land Management or by a decree of a Court of Law and/or that the corner points mentioned in lines 3, 4 and 5 above were in conformance with the rules of the Michigan Board of Land Surveyors or by a Decree of a Court of Law; established, re-established, monumented, re-monumented, recovered, found as expressed below:

NOTE: Not more than 4 corners, all in the same town and range, may be recorded on this certificate.

A. Description of original monument and accessories and/or subsequent restoration:
(A-7) GLO post set by John Mullett May 4, 1840.

Wits: Pine 14" S 46° W 19 links Tamarack 10" N 10° E 20 links


G.F. DeLa Mater P.S. #693 in 1921 found 3 government bearings & 5" Cedar post all in good condition. Wits: (24" Cedar stump S 81° E 22 links) (10" Pine stump S 45 1/2° W 17 links).

Marcus Schaaf P.S. #3104 found and perpetuated this corner from two original B.T.s. Wits: (12" Pine stump S 46° 19 links - B.T.) (24" Cedar stump S 75° E 24 links - B.T.).

Dean C. DeLa Mater in 1951 placed & witnesses Department of Conservation 1" pipe & 4" brass cap. Filed DOC LCR. Wits: (8" Spruce S 6° W 40 links) (10" Spruce N 33° E 81 links) (8" Spruce N 11° W 43 links).

B. Description of corner evidence found and/or method applied in restoring or reestablishing corner:

(A-7) Found 1" pipe and 4" brass cap 12" above ground set by DeLa Mater, (DOC standard corner).

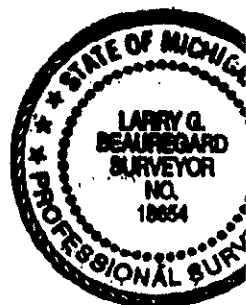

C. Description of monument for corner and accessories established to perpetuate locating the position of the corner:

(A-7) Section corner common to Sections 18 & 19, T 31 N, R 1 E and Sections 13 & 24, T 31 N, R 1 W

1" pipe and 4" brass cap 12" above ground. Accepted as a perpetuation of the original government corner. Approved by the Peer Group on May 13, 1994.

8" Cedar S 50° W 13.85', NBT, Ex. spike - Placed blaze N. & T.

7" Cedar N 45° E 7.60' NBT Ex. spike

13" Cedar S 30° E 25.43' (R) old (NBT)

13" Cedar S 57° E 12.01' NBT Ex. spike

7" Cedar N 35° W 13.89' New NBT

Placed blaze, 20 perry spike & P.S. tag #18654 (typ)

Signed by Larry G. Beauregard
Surveyor's Michigan License No. 18654

Date 11/2/94