

SURVEY & REMONUMENTATION

APR 24 1995

LAND CORNER RECORDATION CERTIFICATE
Filing Requirement of Act 74, Mich. P.A. 1970

For corners **COMMISSION**

Montmorency
(County)

Located in: Vienna Twp Corner Code ##

STATE OF MICHIGAN
MONTMORENCY COUNTY
Recorded & Filed

11-02-1994 15:46:29

A. PANGAN-MCELROY
REGISTER OF DEEDS

Register of Deeds Stamp & File Number

- 1. Public Land Survey T 31N R 1E (A-11)
- T _____ R _____
- T _____ R _____
- T _____ R _____
- 2. Property Controlling S _____ T _____ R _____
- in Section S _____ T _____ R _____
- 3. Miscellaneous S _____ T _____ R _____
- Property in Sec. S _____ T _____ R _____

**APPROVED BY
PEER GROUP**

MAY 13 94

- 4. Lot No. _____, Recorded Plat _____
- 5. Private Claims _____

	A	B	C	D	E	F	G	H	I	J	K	L	M
2	6	5	4	3	2	1							
3													
4	7	8	9	10	11	12							
5													
6	18	17	16	15	14	13							
7													
8	19	20	21	22	23	24							
9													
10	30	29	28	27	26	25							
11													
12	31	32	33	34	35	36							
13													

I, Larry G. Beauregard in a field survey on March, 19 94 do hereby certify that under requirements of P.A. 74, Michigan P.A. of 1970, the corner points mentioned in lines 1 and 2 above were in conformance with regulations and rules therefore as required in the current manual of survey instructions of the United States Department of the Interior, Bureau of Land Management or by a decree of a Court of Law and/or that the corner points mentioned in lines 3, 4 and 5 above were in conformance with the rules of the Michigan Board of Land Surveyors or by a Decree of a Court of Law, established, re-established, monumented, re-monumented, recovered, found as expressed below:

NOTE: Not more than 4 corners, all in the same town and range, may be recorded on this certificate.

A. Description of original monument and accessories and/or subsequent restoration:

(A-11) GLO post set by John Mullett May 4, 1840.


Wits: Pine 10" S 40° W 14 links Hemlock 8" N 41° E 16 links

G.F. DeLaMater P.S. #693 (Otsego Co. Surveyor) in 1921 fnd. post & pitch fork at corner & roots of W. Pine stp. S 40° W 14 links & marked: (W. Birch 4" N 55° W 109 links) (W. Pine stp. 15" S 7° W 48 links) (W. Pine 12" N 81 1/2° W 171.9') (W. Pine stp. 12" S 26 1/2° E 79.2'). Peter E. Chenard P.S. #4200 in 1974 fnd. 1/2" bar & witnesses per Otsego County Survey record Filed an Act 74, Rec. L. 1, P. 437, Otsego Co. records. Wits. fnd.: (Conc. Mon. S 45° W 46.8') (14" Maple S 55° W 57.50') (6" W. Pine S 70° E 83.92') (14" Oak N 35° W 106.36') (C/L Bit. Pave East 36').

Carl R. Johnson P.S. #30083 (DNR Surveyor) in 1991 fnd. & accepted concrete monument at tl corner from witnesses by Chenard.

B. Description of corner evidence found and/or method applied in restoring or reestablishing corner:

(A-11) Fnd. concrete monument 6" below gravel road surface, 36' West of Meridian Line Rd. (Ex. Bit. Pave.) Placed 3" diameter aluminum cap #18654 marked Montmorency County Re-men. cor. on same.

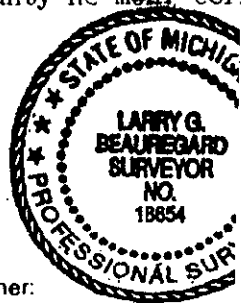

C. Description of monument for corner and accessories established to perpetuate locating the position of the corner:

(A-11) Sec. Cor. Comm. to Sec's 25 & 36, T31N, R1W & Sec's 30 & 31, T31N, R1E. 4" x 36" Conc. Mon. & Re-Mon. cap #18654. Accepted as a perpetuation of the original government corner. Approved by the Peer Group on May 13, 1994.

S 45° W 46.80' Conc. Mon. flush with ground. (R) Placed P.K. nail & P.S. tag #18654 on N 17° W 106.53' 23" Oak (R) N 48° E 118.98' 10" W. Pine (Placed blaze, 20 penny st & P.S. tag #18654).
N 74° E 105.42' P. Pole S 40° W 43.81' P. Pole (R) Ex. P.S. tag #15410.
(Placed P.K. nail & tag #18654)

Signed by Larry G. Beauregard Date 11/2/94
Surveyor's Michigan License No. 18654