

LAND CORNER RECORDATION CERTIFICATE
Filing Requirement of Act 74, Mich. P.A. 1970

For corners in

Montmorency
(County)

Located In:

Corner Code ##

- | | | | | | | | |
|---------------------------------------|---|------------|---|------------|-------------|-----------|-----------|
| 1. Public Land Survey | T | <u>31N</u> | R | <u>2E</u> | <u>I-9</u> | | |
| | T | <u>31N</u> | R | <u>2E</u> | <u>I-10</u> | | |
| | T | <u>31N</u> | R | <u>2E</u> | <u>I-11</u> | | |
| | T | _____ | R | _____ | _____ | | |
| 2. Property Controlling
in Section | S | <u>27</u> | T | <u>31N</u> | R | <u>2E</u> | <u>14</u> |
| | S | _____ | T | _____ | R | _____ | _____ |
| 3. Miscellaneous
Property in Sec. | S | _____ | T | _____ | R | _____ | _____ |
| | S | _____ | T | _____ | R | _____ | _____ |

Register of Deeds Stamp & File Number

4. Lot No. _____, Recorded Plat _____
5. Private Claims _____

I, Carl R. Johnson, in a field survey on May 15, 19 90, do hereby certify that under requirements of P.A. 74, Michigan P.A. of 1970, the corner points mentioned in lines 1 and 2 above were in conformance with regulations and rules therefore as required in the current manual of survey instructions of the United States Department of the Interior, Bureau of Land Management or by a decree of a Court of Law and/or that the corner points mentioned in lines 3, 4 and 5 above were in conformance with the rules of the Michigan Board of Land Surveyors or by a Decree of a Court of Law; established, re-established, monumented, re-monumented, recovered, found as expressed below:

NOTE: Not more than 4 corners, all in the same town and range, may be recorded on this certificate.

	A	B	C	D	E	F	G	H	I	J	K	L	M
2	6	5	4	3	2	1							
3													
4	7	8	9	10	11	12							
5													
6	18	17	16	15	14	13							
7													
8	19	20	21	22	23	24							
9													
10	30	29	28	27	26	25							
11													
12	31	32	33	34	35	36							
13													

A. Description of original monument and accessories and/or subsequent restoration:

B. Description of corner evidence found and/or method applied in restoring or reestablishing corner:
 I-9 Found DNR Monument in place and re-witnessed.

I-10 Found 3/8" bar in place with witnesses.

I-11 Found old square scribed post in place with witnesses also another old post point along side.


14 Set by standard survey procedure for subdivision of a section.

C. Description of monument for corner and accessories established to perpetuate locating the position of the corner:

I-9 NE Corner
 Found DNR Monument
 6" W.Pine N53°W 41.5ft
 9" R.Oak S68°E 18.5ft
 16" W.Pine S31°W 31.7ft

I-10 E 1/4 Corner
 12" Tamrack S86°E 15.8ft
 7" Tamrack S56°W 34.0ft

I-11 SE Corner
 Set DNR Monument
 5" Cedar N45°W 17.6ft
 5" Tamrack N17°E 29.3ft
 6" Cedar S61°E 9.7ft
 4" Cedar S18°W 16.9ft
14 S1/8 Corner on E.Side
 Set 5/8" Bar with cap
 4" Tamrack S40°W 12.3ft
 4" Tamrack N7°W 9.6ft
 3" Tamrack S84°E 23.2ft

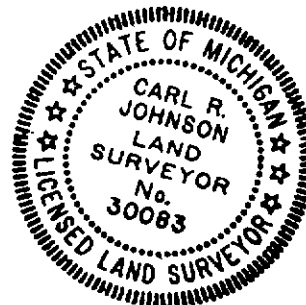

Signed by Carl R. Johnson Date 5/24/90
 Surveyor's Michigan License No. 30083