

LAND CORNER RECORDATION CERTIFICATE
Filing Requirement of Act 74, Mich. P.A. 1970

For corners in

<u>Montmorency</u> (County)	Located In:	Corner Code \neq
1. Public Land Survey	T _____ R _____	_____
	T _____ R _____	_____
	T _____ R _____	_____
	T _____ R _____	_____
2. Property Controlling in Section	S <u>18</u> T <u>31</u> N R <u>3E</u>	<u>4</u>
	S <u>7</u> T <u>31</u> N R <u>3E</u>	<u>3</u>
3. Miscellaneous Property in Sec.	S _____ T _____ R _____	_____
	S _____ T _____ R _____	_____

Register of Deeds Stamp & File Number

4. Lot No. _____, Recorded Plat _____
 5. Private Claims _____

I, Carl R. Johnson, in a field survey on October 4, 19 88, do hereby certify that under requirements of P.A. 74, Michigan P.A. of 1970, the corner points mentioned in lines 1 and 2 above were in conformance with regulations and rules therefore as required in the current manual of survey instructions of the United States Department of the Interior, Bureau of Land Management or by a decree of a Court of Law and/or that the corner points mentioned in lines 3, 4 and 5 above were in conformance with the rules of the Michigan Board of Land Surveyors or by a Decree of a Court of Law; established, re-established, monumented, re-monumented, recovered, found as expressed below:

NOTE: Not more than 4 corners, all in the same town and range, may be recorded on this certificate.

	A	B	C	D	E	F	G	H	I	J	K	L	M
2	6	5	4	3	2	1							
3													
4	7	8	9	10	11	12							
5													
6	18	17	16	15	14	13							
7													
8	19	20	21	22	23	24							
9													
10	30	29	28	27	26	25							
11													
12	31	32	33	34	35	36							
13													

A. Description of original monument and accessories and/or subsequent restoration:


B. Description of corner evidence found and/or method applied in restoring or reestablishing corner:

- 4 - Set by standard procedure for subdividing a section.
- 3 - Set midway and on line between $\frac{1}{4}$ corner and section corner.

C. Description of monument for corner and accessories established to perpetuate locating the position of the corner:

- | | |
|---|---|
| 4 - <u>Center of NW$\frac{1}{4}$</u>
Set <u>5/8"</u> bar w/cap & cedar post | 3 - <u>N1/8 corner on W. side</u>
Set <u>5/8"</u> bar w/cap & cedar post |
| 9" Oak N42°E 33.4' | 6" Maple S65°W 15.0' |
| 8" Oak S47°E 18.6' | 6" Maple S30°E 32.6' |
| 6" Oak N82°W 8.2' | 14" R. Pine STD N28°E 5.3' |
| | Fence cor N30°W 0.7' |

Signed by Carl R. Johnson
 Surveyor's Michigan License No. 30083

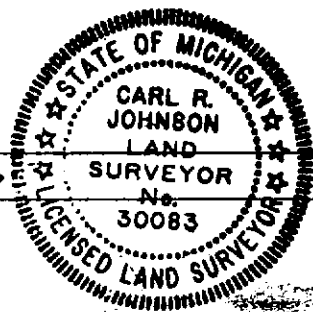

Date 8/7/89