

**LAND CORNER RECORDATION CERTIFICATE**  
**Filing Requirement of Act 74, Mich. P.A. 1970**

For corners in

Montmorency  
(County)

Located In:

Corner Code #

- |                                    |   |           |   |            |       |           |          |
|------------------------------------|---|-----------|---|------------|-------|-----------|----------|
| 1. Public Land Survey              | T | _____     | R | _____      | _____ |           |          |
|                                    | T | _____     | R | _____      | _____ |           |          |
|                                    | T | _____     | R | _____      | _____ |           |          |
|                                    | T | _____     | R | _____      | _____ |           |          |
| 2. Property Controlling in Section | S | <u>18</u> | T | <u>31N</u> | R     | <u>3E</u> | _____    |
|                                    | S | <u>18</u> | T | <u>31N</u> | R     | <u>3E</u> | <u>3</u> |
| 3. Miscellaneous Property in Sec.  | S | _____     | T | _____      | R     | _____     | _____    |
|                                    | S | _____     | T | _____      | R     | _____     | <u>1</u> |

Register of Deeds Stamp & File Number

4. Lot No. \_\_\_\_\_, Recorded Plat \_\_\_\_\_  
 5. Private Claims \_\_\_\_\_

I, Carl R. Johnson, in a field survey on October 4, 19 88, do hereby certify that under requirements of P.A. 74, Michigan P.A. of 1970, the corner points mentioned in lines 1 and 2 above were in conformance with regulations and rules therefore as required in the current manual of survey instructions of the United States Department of the Interior, Bureau of Land Management or by a decree of a Court of Law and/or that the corner points mentioned in lines 3, 4 and 5 above were in conformance with the rules of the Michigan Board of Land Surveyors or by a Decree of a Court of Law; established, re-established, monumented, re-monumented, recovered, found as expressed below:

**NOTE: Not more than 4 corners, all in the same town and range, may be recorded on this certificate.**

	A	B	C	D	E	F	G	H	I	J	K	L	M
2	6		5		4		3		2		1		
3													
4	7		8		9		10		11		12		
5													
6	18		17		16		15		14		13		
7													
8	19		20		21		22		23		24		
9													
10	30		29		28		27		26		25		
11													
12	31		32		33		34		35		36		
13													

A. Description of original monument and accessories and/or subsequent restoration:

B. Description of corner evidence found and/or method applied in restoring or reestablishing corner:

- 3 - Set midway and on line between  $\frac{1}{2}$  corner and section corner.
- 1 - Set single proportionately and on line between  $\frac{1}{2}$  corner and section corner.

C. Description of monument for corner and accessories established to perpetuate locating the position of the corner:


- |                                  |                                 |
|----------------------------------|---------------------------------|
| 3 - N1/8 on west side            | 1 - W1/8 on N. side             |
| Set 5/8" bar w/cap               | Set 5/8" bar w/cap & cedar post |
| 12" R. pine S24°E 53.7'          | 5" R. Pine N41°W 17.6 ft        |
| 6" Maple S84°W 18.1'             | 4" R. Pine N51°E 50.3 ft        |
| Cedar Post N85°W 12'             | 4" Maple S42°E 25.7 ft          |
| Corner in centerline of N-S Road |                                 |

Signed by

*Carl Johnson*

Surveyor's Michigan License No.

30083

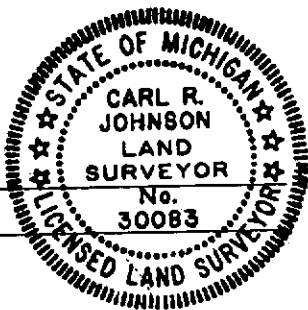

Date

8/7/89