LAND CORNER RECORDATION CERTIFICATE
Filing Requirement of Act 74, Mich. P.A. 1970

For corners in MONTMORENCY (County)

	Located In:	Corner Code ##
1. Public Land Survey	T 31N R 3E	H-5
	T ___ R ___	I-5
	T ___ R ___	
	T ___ R ___	
2. Property Controlling	S 10 T ___ R ___	16
in Section	S 10 T ___ R ___	9
3. Miscellaneous	S ___ T ___ R ___	
Property in Sec.	S ___ T ___ R ___	

Register of Deeds Stamp & File Number

4. Lot No. _____ , Recorded Plat _____
5. Private Claims _____

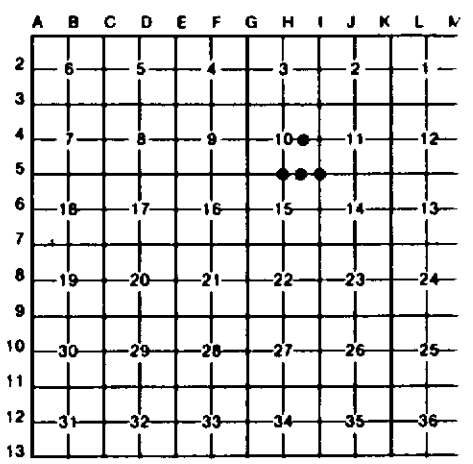

I, CARL R. JOHNSON , in a field survey on JANUARY 17 , 19 92 , do hereby certify that under requirements of P.A. 74, Michigan P.A. of 1970, the corner points mentioned in lines 1 and 2 above were in conformance with regulations and rules therefore as required in the current manual of survey instructions of the United States Department of the Interior, Bureau of Land Management or by a decree of a Court of Law and/or that the corner points mentioned in lines 3, 4 and 5 above were in conformance with the rules of the Michigan Board of Land Surveyors or by a Decree of a Court of Law; established, re-established, monumented, re-monumented, recovered, found as expressed below:

NOTE: Not more than 4 corners, all in the same town and range, may be recorded on this certificate.

A. Description of original monument and accessories and/or subsequent restoration:

H-5	I-5	16	9

B. Description of corner evidence found and/or method applied in restoring or reestablishing corner:

H-5	I-5	16	9
SET MIDWAY AND ON LINE BETWEEN SECTION CORNERS.	SET CORNER ON LINE WITH OLD FENCE LINE EAST AND AT RECORD DISTANCE FROM THE SW CORNER OF SECTION 10. FALLS WITHIN A COUPLE OF FEET OF OCCUPATION FENCE CORNER.	SET BY STANDARD PROCEDURE FOR SUBDIVISION OF A SECTION.	SET BY STANDARD PROCEDURE FOR SUBDIVISION OF A SECTION.

STATE OF MICHIGAN
CARL R. JOHNSON
LAND SURVEYOR
No. 30083
LICENSED LAND SURVEYOR

C. Description of monument for corner and accessories established to perpetuate locating the position of the corner:

H-5	I-5	16	9
S1/4 COR. SEC. 10	SE COR. SEC. 10	E1/8 COR. ON S. LINE SEC. 10	E1/8 COR. ON E-W 1/4 LINE S.10
DNR MON.	DNR MON.	5/8" BAR W/CAP	5/8" BAR W/CAP
MAPLE CLUMP N24E 51 5 FT.	R.PINE 7" S51E 43.9 FT.	OAK 14" N30W 33.1 FT.	BALSAM 4" S59W 8.8 FT.
TWIN OAK 14" N36W 106.6 FT.	R.PINE 14" N64E 48.9 FT.	J.PINE 8" S54W 19.3 FT.	J.PINE 8" S25E 33.8 FT.
OAK 24" S43W 172.9 FT.	TWIN MAPLE S49W 41.8 FT.	R.PINE 12" EAST 35.9 FT.	BALSAM 5" N30W 38.4 FT.
CEDAR POST N40E 22 6 FT.	J.PINE 10" N89W 4.5 FT.	FENCE COR. S49E 32.5 FT.	OLD PROP. COR.N16E 12.0 FT.
	APPROX. 20 FT. EAST TO N-S FIREBREAK TRAIL.		

Signed by Carl R. Johnson Date 3/17/92

Surveyor's Michigan License No. 30083

FORM APPROVED BY MICHIGAN STATE BOARD OF LAND SURVEYORS, JAN. 28, 1971
REVISED MAY 14, 1975
REVISED JAN., 198