


LAND CORNER RECORDATION CERTIFICATE

Filing Requirement of Act 74, Mich. PA 1970

For Corners In: Montmorency (County)	Located In	Corner Code #
1. Public Land Survey	T _____ R _____	_____
	T _____ R _____	_____
2. Property Controlling in Section	S 34 T 31N R 3E	1
	S _____	_____
3. Miscellaneous Property in Section	S _____ T _____ R _____	_____
	S _____ T _____ R _____	_____
4. Lot No: _____	Recorded Plat: _____	
5. Private Claims: _____		

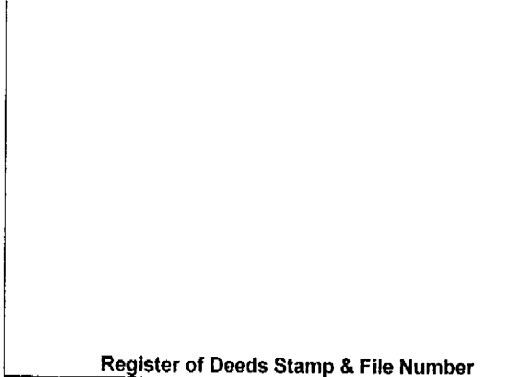

I, Carl T. Kiiskila, in a field survey on May 23, 2005 do hereby state that under requirements of PA 74, Michigan PA of 1970, the corner points mentioned in lines 1 and 2 above were in conformance with regulations and rules therefore as required in the current manual of survey instructions of the United States Department of the Interior, Bureau of Land Management or by a decree of a Court of Law and/or that the corner points mentioned in lines 3, 4 and 5 above were in conformance with the rules of the Michigan Board of Land Surveyors or by a Decree of a Court of Law; established, re-established, monumented, recovered, found as expressed below.

NOTE: Not more than 2 corners, all in the same town and range, may be recorded on this certificate.

	A	B	C	D	E	F	G	H	I	J	K	L	M
1													
2	6		5		4		3		2		1		
3													
4	7		8		9		10		11		12		
5													
6	18		17		16		15		14		13		
7													
8	19		20		21		22		23		24		
9													
10	30		29		28		27		26		25		
11							●						
12	31		32		33		34		35		36		
13													

A. Description of original monument and accessories and/or subsequent restoration:

1- June 1974, Kenneth Ostling RLS #10068 set a 1"x30" pipe for the Northeast corner of the Northwest quarter of the Northwest quarter of section 34 by standard survey procedure.

Wit:	19" R. Oak	S60°E	74.8'
	26" Twin Oak	S04°E	29.3'

B. Description of corner evidence found and/or method applies in restoring or re-establishing corner:

1- Found a 60d spike fitting K. J. Ostling survey in section 34.

C. Description of monument for corner and accessories established to perpetuate locating the position of the corner:

1- Set a 5/8" x 32" rered with P.S. cap #33981

Wit:	22" Oak	S50°W	84.03'
	24" W. Pine	N16°E	73.93'
	7" W. Pine	S11°W	62.53'
	5" W. Pine	S45°E	51.05'

Pin falls in the center line E-W gravel road



Signed by: Carl T. Kiiskila
 Surveyor's Michigan License No.: 33981

Date: 5/25/05