

# LAND CORNER RECORDATION CERTIFICATE

## FILING REQUIREMENT OF ACT 74, MICH. P.A.1970

FOR CORNERS OF—	LOCATED IN—	CORNER CODE NUMBER
1. PUBLIC LAND SURVEY	T. <u>31</u> N. R. <u>4</u> E.	A-13
2. PROPERTY CONTROLLING IN SECTION— <u>31</u>	T. <u>31</u> N. R. <u>4</u> E.	12
3. MISCELLANEOUS PROPERTY IN SECTION—	T. _____ N. S. R. _____ E. W.	
4. LOT NO. _____, RECORDED PLAT _____		
5. PRIVATE CLAIMS _____		

REGISTER OF DEEDS STAMP AND FILING NUMBER

I, KENNETH J. OSTLING, do hereby certify that under requirements of P.A. 74, Michigan P.A. of 1970, the corner points mentioned in lines 1 and 2 above were, in a field survey on DECEMBER 7, 1982, established, re-established, monumented, re-monumented, recovered or restored as expressed below and in conformance with regulations and rules therefore as required in the current manual of survey instructions of the United States Department of the Interior, Bureau of Land Management or by a decree of a court of law. Furthermore, that the corner points mentioned in lines 3, 4 and 5 above were, in a field survey on \_\_\_\_\_, 19\_\_\_\_, found, recovered, restored, established or re-established as expressed below and in conformance with the rules of the Michigan State Board of Registration for Land Surveyors or, by a Decree of a Court of law:

A. Description of original monument and accessories and/or subsequent restoration:

B. Description of corner evidence found and/or method applied in restoring or re-establishing corner:

12 SET BY STANDARD SURVEY PROCEDURE FOR THE SUBDIVISION OF SECTIONS.

A-13 FOUND SQUARE POST AND STEEL FENCE POST AS IDENTIFIED BY MSHD SURVEY IN 1965. ORIGIN UNKNOWN BUT APPEARS BEST AVAILABLE EVIDENCE.


C. Description of monument for corner and accessories established to perpetuate locating the position of the corner:

12  
 SET 5/8 X 30" BAR W/CAP  
 8" JACK PINE N53°E 10.7'  
 10" JACK PINE N73°W 14.9'  
 10" JACK PINE S50°E 2.5'

A-13  
 SET DNR MONUMENT  
 NOTHING NEAR FOR NBT'S  
 N 1/4 CORNER SECTION 6, T30N, R4E IS  
 N89°45'00E 1.2'

SIGNED BY *Kenneth J. Ostling*  
 KENNETH J. OSTLING  
 SURVEYOR'S MICHIGAN REGISTRATION NO. 10068

DATE 1/18/83

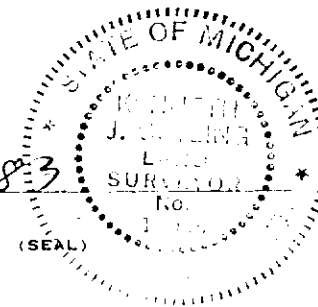

FOR STATE AND UNITED STATES AGENCIES:

SIGNED BY \_\_\_\_\_ DATE \_\_\_\_\_  
CHIEF OF SURVEY PARTY  
 APPROVED AND SIGNED BY \_\_\_\_\_ DATE \_\_\_\_\_  
MICHIGAN REGISTERED LAND SURVEYOR (SEAL)

SURVEYOR'S MICHIGAN REGISTRATION NO. \_\_\_\_\_ MONTMORENCY COUNTY