# LAND CORNER RECORDATION CERTIFICATE

**Filing Requirement of Act 74, Mich. P.A. 1970**

For corners in MONTMORENCY (County)

| | Located In: | Corner Code ## |
|---|---|---|
| 1. Public Land Survey | T 31N R 4E | A-8 |
| | T ___ R ___ | A-7 |
| | T ___ R ___ | A-6 |
| | T ___ R ___ | |
| 2. Property Controlling | S ___ T ___ R ___ | |
| in Section | S ___ T ___ R ___ | |
| 3. Miscellaneous | S ___ T ___ R ___ | |
| Property in Sec. | S ___ T ___ R ___ | |

**Register of Deeds Stamp & File Number**

4. Lot No. _____ , Recorded Plat _____
5. Private Claims _____

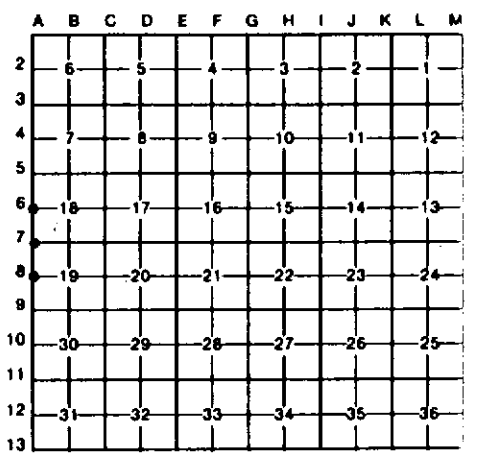


I, CARL R. JOHNSON, in a field survey on APRIL 1, 19 92, do hereby certify that under requirements of P.A. 74, Michigan P.A. of 1970, the corner points mentioned in lines 1 and 2 above were in conformance with regulations and rules therefore as required in the current manual of survey instructions of the United States Department of the Interior, Bureau of Land Management or by a decree of a Court of Law and/or that the corner points mentioned in lines 3, 4 and 5 above were in conformance with the rules of the Michigan Board of Land Surveyors or by a Decree of a Court of Law; established, re-established, monumented, re-monumented, recovered, found as expressed below:

**NOTE: Not more than 4 corners, all in the same town and range, may be recorded on this certificate.**

A. Description of original monument and accessories and/or subsequent restoration:

| A-8 | A-7 | A-6 |
|---|---|---|
| | | |

B. Description of corner evidence found and/or method applied in restoring or reestablishing corner:

| A-8 | A-7 | A-6 |
|---|---|---|
| Set midway and on line between found section corners. No evidence of original or subsequent survey. | Found monument in place and accepted as true position for corner. | Set midway and on line between found section corners. No evidence of original or subsequent survey. |

C. Description of monument for corner and accessories established to perpetuate locating the position of the corner:

| A-8 | A-7 | A-6 |
|---|---|---|
| West 1/4 corner section 19 | SW corner section 18 | West 1/4 corner section 18 |
| Set 3/4" Iron Pipe w/cap | Found 1 1/2" Iron Pipe | Set DNR Monument |
| Jack Pine 5" S34E 14.7 ft | Red Pine 12" N49W 15.7 ft | Oak 5" N02W 37.7 ft |
| Oak 8" N33E 22.2 ft | Jack Pine 10" N78E 37.3 ft | Aspen 5" N30E 15.5 ft |
| Jack Pine 6" S61W 17.8 ft | Jack Pine 8" S51E 49.2 ft | Jack Pine 5" S39E 16.1 ft |
| Centerline of county road 29.0 feet east. | Oak 5" S18W 39.4 ft | Maple 10" S41W 34.5 ft |
| | Centerline of county road 20 feet east. | |

STATE OF MICHIGAN
CARL R. JOHNSON
LAND SURVEYOR
No. 30083
LICENSED LAND SURVEYOR

Signed by Carl R. Johnson Date 7/7/92

Surveyor's Michigan License No. 30083

FORM APPROVED BY MICHIGAN STATE BOARD OF LAND SURVEYORS, JAN. 28, 1971
REVISED MAY 14, 1975
REVISED JAN., 1983