SURVEY & REMONUMENTATION

APR 2 4 1995

COMMISSION

Montmorency County Remonumentation

Liber 00012 Page 0074

LAND CORNER RECORDATION CERTIFICATE

Filing Requirement of Act 74, Mich. P.A. 1970

For corners in MONTMORENCY (County)

Located In: HILLMAN TWP.

Corner Code ##

1. Public Land Survey — T 31N R 4E — E-1
2. Property Controlling in Section — S ___ T ___ R ___
3. Miscellaneous Property in Sec. — S ___ T ___ R ___

APPROVED BY PEER GROUP

AUG 0 5 94

STATE OF MICHIGAN
MONTMORENCY COUNTY
Recorded & Filed

10-19-1994 13:49:07

Register of Deeds Stamp & File Number

REGISTER OF DEEDS

4. Lot No. _____, Recorded Plat _____
5. Private Claims _____

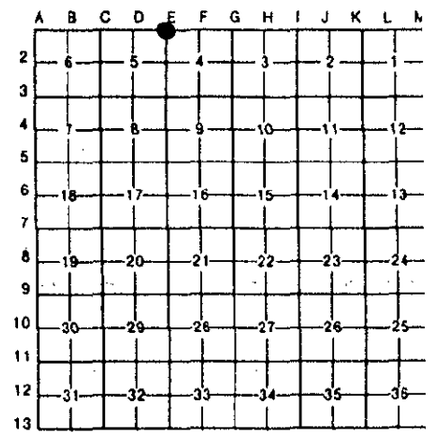

I, FREDERICK J. KING, in a field survey on July 28, 19 94, do hereby certify that under requirements of P.A. 74, Michigan P.A. of 1970, the corner points mentioned in lines 1 and 2 above were in conformance with regulations and rules therefore as required in the current manual of survey instructions of the United States Department of the Interior, Bureau of Land Management or by a decree of a Court of Law and/or that the corner points mentioned in lines 3, 4 and 5 above were in conformance with the rules of the Michigan Board of Land Surveyors or by a Decree of a Court of Law; established, re-established, monumented, re-monumented, recovered, found as expressed below:

NOTE: Not more than 4 corners, all in the same town and range, may be recorded on this certificate.

A. Description of original monument and accessories and/or subsequent restoration:

E-1 CORNER COMMON TO SECTION 4 & 5

July 1855 - Original Post set by Butler Ives, D.S. - CORNER IS IN "DOLLAR LAKE"
Set Meander Post on W Shore of Lake - Cor E-1 is 198.0' (3 Ch) East - S06E - W Pine - 6.60' (10 lks)
N50W - Blk Oak - 31.12' (32 lks)

Set Meander Post on S Shore of Lake - Cor E-1 is 165.0' (2.5 Ch) North - S30W - Y Pine - 7.92' (12 lks)
S75E - Maple - 32.34' (49lks)

May 1947 - W. Meander Post - Fnd 1" Galv Pipe - Set 4" pipe & Cap - GLO W Pine Stump with scribes in place
N88°30'W - 59.0' - 14" Y Pine - S56°45'W - 75.7' - 30" W Pine Stump - N65°30'W - 68.5' - 20" W Pine Stm

S.Meander Post - Fnd 1" Galv Pipe - Set 4" Pipe & Cap. S32°15'W - 36.3'-18" Y Pine NBT & Brass Tag G.F. Delamater 1933.
S38°30'W -8.0' -GLO W Pine Stump. S75°E - 49.1' - Maple

UN-DATED - Field Data obtained from L.G. Beauregard, PS #18654 - Shows Post Fnd on W Shore of lk set by Delmater July 1933. - Shows Ref Post on W Shore of Lk to be 206.4' W of E-1. Shows Ref Post on S Shore of Lk to be 160.0' S of Cor E-1.

W. Meander Post - S54W-75.7' - 36" W Pine Stump - N67½W-68.5' -30" W Pine Stump
S Meander Post - Fnd Axle Shaft - S60E - 6" Maple -3.30' -S35W - 8" Oak - 8.76' - N25E - 3" Oak - 31.48'

NO ACT # 74 FOUND RECORDED FOR THIS CORNER
NO ACT # 132 FOUND RECORDED FOR THIS CORNER

B. Description of corner evidence found and/or method applied in restoring or reestablishing corner:

E-1 CORNER COMMON TO SECTION 4 & 5

7-28-94 --W-M.P. on N. Sec Line
Fnd 4" Pipe with DNR Cap mkd
Set G.A. Shadko in 1947
with 1" Pipe on NE Side &
Sq Top Cedar Post laying down
N10W - 21.12' - Old Blaze in Oak
N60W - 19.23' - Old Blaze in Oak
No 1855 Wit Fnd

S-M.P2 on E Sec Line
Fnd 4" Pipe with DNR Cap mkd Set by G.A. Shadko in 1947 with Cedar Post along side
S35W - 8.5' (R-8.76') Fnd Blaze in Burnt Stump
S30W - 36.75' (R-S32W-36.3') - Fnd Delamater Tag in R Pir
No 1855 Wit Fnd

This Corner Approved by County Peer Review on Aug. 5, 1994, as the Best available evidence of the original corner.

C. Description of monument for corner and accessories established to perpetuate locating the position of the corner:

E-1 7-28-94 - W. Meander Post - Fnd 4" Pipe & Shadko Cap & 1" Pipe. Cor is ± 20' W of W edge "Dollar Lk"
S - 15.18' - Set Tag on E sd of 15" Oak - W- 59.11' - Set Tag S sd 24" R Pine - N60°W - 19.23'- Set Tag NE sd 18" Oak - N10°W 21.12' - Set Tag E sd 15" Oak - Set Treated 2"x4" Alongside
This Cor is 206.4' W of Cor E-1 per Shadko Notes.

S. Meander Post - Fnd 4" Pipe & Shadko Cap - Cor is ± 8' S of S Edge of "DOLLAR LK."
S65°E - 32.41' - Set Tag - SW sd of 12" Oak
S20°E - 14.73' - Set Tag - W sd W. Birch in Tri-Birch Clump
S30°W - 36.75' - Fnd Delamater Tag in N sd R. Pine
S35°W - 8.5' - Fnd Blaze in Burnt Stump
S55°W - 21.70' - Set Tag in SE sd 12" Oak
Existing Cedar Post Alongside
This Corner is 160.6' S of Cor E-1 per Shadko Notes.

STATE OF MICHIGAN
FREDERICK J. KING
PROFESSIONAL SURVEYOR
No. 25852
LICENSED PROFESSIONAL SURVEYOR

Signature Frederick J. King Date 10-18-94

Surveyor's Michigan License No. 25852

FORM APPROVED BY MICHIGAN STATE BOARD OF LAND SURVEYORS JAN 26 19
REVISED MAY 14, 19
REVISED JAN. 19