

LAND CORNER RECORDATION CERTIFICATE


Filing Requirement of Act 74, Mich. PA 1970

For Corners In: Montmorency (County)	Located In	Corner Code #
1. Public Land Survey	T 31N R 4E	D-10
	T	
2. Property Controlling in Section	S 29 T 31N R 4E	4
	S	
3. Miscellaneous Property in Section	S T R	
	S T R	
4. Lot No: _____	Recorded Plat: _____	
5. Private Claims: _____		

Register of Deeds Stamp & File Number

I, Carl T. Kiiskila, in a field survey on May 23, 2005 do hereby state that under requirements of PA 74, Michigan PA of 1970, the corner points mentioned in lines 1 and 2 above were in conformance with regulations and rules therefore as required in the current manual of survey instructions of the United States Department of the Interior, Bureau of Land Management or by a decree of a Court of Law and/or that the corner points mentioned in lines 3, 4 and 5 above were in conformance with the rules of the Michigan Board of Land Surveyors or by a Decree of a Court of Law; established, re-established, monumented, recovered, found as expressed below:

NOTE: Not more than 2 corners, all in the same town and range, may be recorded on this certificate.

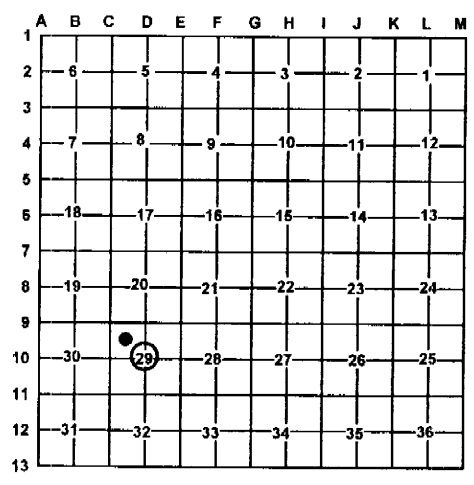

A. Description of original monument and accessories and/or subsequent restoration:

D-10 This corner position was not established during the original government survey. 4- This corner position was not established during the original government survey.

B. Description of corner evidence found and/or method applies in restoring or re-establishing corner:

D-10 Established the center of section 29 at the intersection of North-South and the East- West quarter lines. 4- Established the Southwest corner of the Northeast quarter of the Northwest quarter of section 29 as per B.L.M. instructions for the subdivision of a section.

C. Description of monument for corner and accessories established to perpetuate locating the position of the corner:

D-10 Set 5/8" X 32" rerod with P.S. cap #33981 Wit: 6" Maple N62°E 6.87' 6" Maple N23°E 16.47' 3" Balsam S70°W 17.67' 3" Balsam S23°E 52.52' Blue Carsonite Post North 1±	4- Set 5/8" X 32" rerod with P.S. cap #33981 Wit: 16" Oak S74°W 26.06' 6" R. Pine S41°W 28.02' NE corner of building S16°E 41.80' Power Pole S81°E 91.62' Blue Carsonite Post North 1±
--	---

Signed by: Carl T. Kiiskila
 Surveyor's Michigan License No.: 33981

Date: 6/13/05

