LAND CORNER RECORDATION CERTIFICATE
Filing Requirement of Act 74, Mich. P.A. 1970

For corners in

MONTMORENCY
(County)

Located In: Corner Code #

1. Public Land Survey		T 32N	R 2E	F-11, G-11
		T___	R___	
		T___	R___	
		T___	R___	
2. Property Controlling	S___	T___	R___	
in Section	S___	T___	R___	
3. Miscellaneous	S___	T___	R___	
Property in Sec.	S___	T___	R___	

Register of Deeds Stamp & File Number

4. Lot No. _____ , Recorded Plat _____
5. Private Claims _____

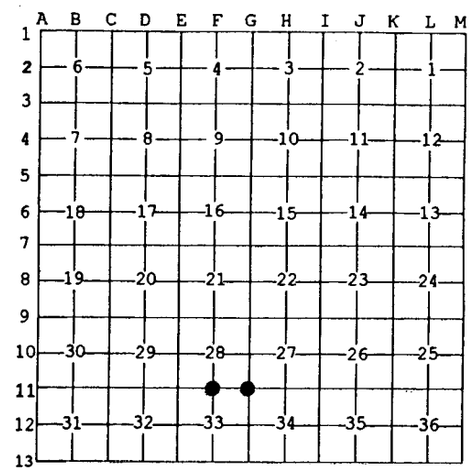

CARL KIISKILA JUNE 2 97

I, _____, in a field survey on _____, 19____ do hereby state that under requirements of P.A. 74, Michigan P.A. of 1970, the corner points mentioned in lines 1 and 2 above were in conformance with regulations and rules therefore as required in the current manual of survey instructions of the United States Department of the Interior, Bureau of Land Management or by a decree of a Court of Law and /or that the corner points mentioned in lines 3, 4 and 5 above were in conformance with the rules of the Michigan Board of Land Surveyors or by a Decree of a Court of Law; established, re-established, monumented, recovered, found as expressed below:

NOTE: Not more than 2 corners, all in the same town and range, may be recorded on this certificate.

A. Description of original monument and accessories and/or subsequent restoration:

F-11 G-11

(NO EVIDENCE OF G.L.O. CORNER, B.T'S, LINE TREES & TOPOGRAPHY, AS CALLED OUT IN THE G.L.O. LINE NOTES; UNLESS NOTED IN ITEM "B" BELOW.)

STATE OF MICHIGAN
CARL KIISKILA
LAND SURVEYOR
No. 33981
LICENSED LAND SURVEYOR

B. Description of corner evidence found and/or method applied in restoring or reestablishing corner:

F-11

FOUND AND ACCEPTED A 1/2" ROD AS WITNESSED BY JERRY WILCOX P.S. #14102 IN LIBER 1, PAGE 273, FOR THE SOUTH 1/4 CORNER OF SECTION 28. THE CORNER FALLS IN A N-S AND E-W FIRE LANE INTERSECTION.

G-11

FOUND AND ACCEPTED A 1/2" ROD AS WITNESSED BY DELMER PORTER P.S. # 15410 IN LIBER 1, PAGE 279, FOR THE S.E. CORNER OF SEC. 28. THIS CORNER POSITION WAS ALSO USED BY RONALD BISCHER P.S. # 22428 AND THE DEPARTMENT OF NATURAL RESOURCES IN PREVIOUS SURVEYS. THE ROD FALLS IN A E-W GRAVEL ROAD.

C. Description of monument for corner and accessories established to perpetuate locating the position of the corner:

F-11

FOUND A 1/2" IRON ROD, PLACED A 1" PIPE WITH CAP OVER FOUND ROD.

JACK PINE 2"	S54°E	55.61'
OAK 2"	S04°E	53.47'
CHERRY 3"	S61°W	48.45'
JACK PINE 8"	N39°W	93.10'
CARSONITE POST	N45°E	33.00'

CL TRAILS N-S AND E-W

G-11

FOUND 1/2" IRON ROD, PLACED 1" PIPE WITH CAP OVER FOUND ROD

JACK PINE 10"	N24°E	60.42'
*JACK PINE 8"	N52°W	51.18'
*OAK 6"	S61°W	51.53'
JACK PINE	S10°E	43.71'

CTR E-W GRAVEL ROAD IS 2' SOUTH

* OLD WITNESSES BY R. BISCHER P.S. #22428

Signed by Carl T Kiiskila Date 8-20-97

Surveyor's Michigan License No. 33981

FORM APPROVED BY MICHIGAN STATE BOARD OF PROFESSIONAL SURVEYORS, JAN. 28, 1971
REVISED MAY 14,1975
REVISED JAN., 1983
REVISED OCT., 1995