LAND CORNER RECORDATION CERTIFICATE

Filing Requirement of Act 74, Mich. P.A. 1970

For corners in MONTMORENCY (County)

	Located In:	Corner Code ##
1. Public Land Survey	T 32N R 3E	K-3,
	T ___ R ___	
	T ___ R ___	
	T ___ R ___	
2. Property Controlling	S 1 T ___ R ___	8, 11
in Section	S ___ T ___ R ___	
3. Miscellaneous	S ___ T ___ R ___	
Property in Sec.	S ___ T ___ R ___	

Register of Deeds Stamp & File Number

4. Lot No. _____ , Recorded Plat _____
5. Private Claims _____

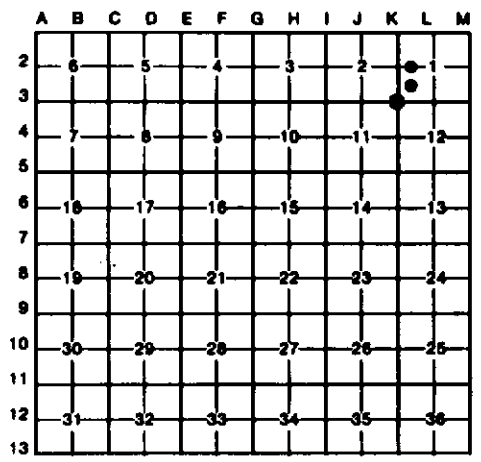

I, CARL KIISKILA, in a field survey on JUNE 11, 19 96, do hereby certify that under requirements of P.A. 74, Michigan P.A. of 1970, the corner points mentioned in lines 1 and 2 above were in conformance with regulations and rules therefore as required in the current manual of survey instructions of the United States Department of the Interior, Bureau of Land Management or by a decree of a Court of Law and/or that the corner points mentioned in lines 3, 4 and 5 above were in conformance with the rules of the Michigan Board of Land Surveyors or by a Decree of a Court of Law; established, re-established, monumented, re-monumented, recovered, found as expressed below:

NOTE: Not more than 4 corners, all in the same town and range, may be recorded on this certificate.

A. Description of original monument and accessories and/or subsequent restoration:

K-3 8 11

(NO EVIDENCE OF G.L.O. CORNER, B.T'S, LINE TREES & TOPOGRAPHY, AS CALLED OUT IN THE G.L.O. LINE NOTES; UNLESS NOTED IN ITEM "B" BELOW.)

B. Description of corner evidence found and/or method applied in restoring or reestablishing corner:

K-3	8	11
FD IRON W/D.MARLATT P.S. CAP FOR SW COR S-1 (FD 5/8"x 63" REROD ON EAST SIDE OF D.M. IR FOR GUARD IRON).	FD D.MARLATT IRON FOR THE NE COR OF THE NW1/4 OF SW1/4 OF SEC. 1. IRON FITS PROPER SUBDIVISION OF SECTION PER STANDARD BLM INSTRUCTIONS.	FD IRON ROD FOR THE SE COR OF NW1/4 OF SW1/4 SEC. 1. COR FITS PROPER SUB'D. OF SECTION PER STANDARD BLM INSTRUCTIONS.

C. Description of monument for corner and accessories established to perpetuate locating the position of the corner:

K-3			8			11		
FD 1/2" REROD W/CAP-D.MARLATT. SET 1"x 36" PIPE W/CAP OVER REROD & SET CARSONITE POST.			PLACED 1" IRON PIPE OVER FD 1/2" IRON ROD BY D.MARLATT #18660.			PLACED 1" IRON PIPE OVER FD 1/2" IRON ROD W/CAP-D.MARLATT #18660.		
8" MAPLE	N65°E	39.55'	#8" SPRUCE	S80°E	11.47'	#14" R.PINE	S52°W	30.55'
10" MAPLE	S34°E	31.79'	#8" TWIN CEDAR	N78°W	14.72'	#5" MAPLE	N26°W	10.64'
8" MAPLE	S50°W	29.73'	#16" CEDAR	S47°W	26.05'	#12"R.PINE	N63°E	11.93'
6" MAPLE	N34°W	45.14'	5" ASH	NORTH	24.71'	4" MAPLE	S21°E	24.59'
#8"W.BIRCH	N62°W	11.6'						
#14"W.BIRCH	S02°W	14.3'						
#OLD WIT. BY OTHERS			#= PS, D.MARLATT WIT.			#= PS, D.MARLATT WIT.		

STATE OF MICHIGAN
CARL KIISKILA
LAND SURVEYOR
No. 33981
LICENSED LAND SURVEYOR

Signed by Carl T. Kiiskila Date 2-27-97

Surveyor's Michigan License No. 33981

FORM APPROVED BY MICHIGAN STATE BOARD OF LAND SURVEYORS, JAN. 20, 1971
REVISED MAY 14, 1975
REVISED JAN., 1983