LAND CORNER RECORDATION CERTIFICATE

Filing Requirement of Act 74, Mich. P.A. 1970

For corners in MONTMORENCY (County)

	Located In:	Corner Code ##
1. Public Land Survey	T 32N R 3E	L-3, M-3
	T ___ R ___	
	T ___ R ___	
	T ___ R ___	
2. Property Controlling	S 1 T ___ R ___	15
in Section	S ___ T ___ R ___	
3. Miscellaneous	S ___ T ___ R ___	
Property in Sec.	S ___ T ___ R ___	

Register of Deeds Stamp & File Number

4. Lot No. _____ , Recorded Plat _____
5. Private Claims _____

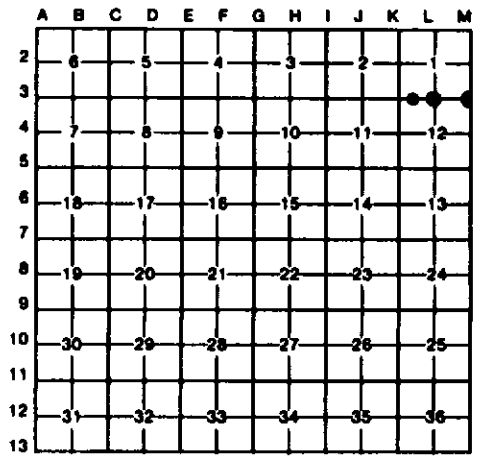

I, CARL KIISKILA, in a field survey on JUNE 11, 19 96, do hereby certify that under requirements of P.A. 74, Michigan P.A. of 1970, the corner points mentioned in lines 1 and 2 above were in conformance with regulations and rules therefore as required in the current manual of survey instructions of the United States Department of the Interior, Bureau of Land Management or by a decree of a Court of Law and/or that the corner points mentioned in lines 3, 4 and 5 above were in conformance with the rules of the Michigan Board of Land Surveyors or by a Decree of a Court of Law; established, re-established, monumented, re-monumented, recovered, found as expressed below:

NOTE: Not more than 4 corners, all in the same town and range, may be recorded on this certificate.

A. Description of original monument and accessories and/or subsequent restoration:

L-3
(NO EVIDENCE OF G.L.O. CORNER, B.T'S, LINE TREES & TOPOGRAPHY, AS CALLED OUT IN THE G.L.O. LINE NOTES; UNLESS NOTED IN ITEM "B" BELOW.)

M-3

15

B. Description of corner evidence found and/or method applied in restoring or reestablishing corner:

L-3
REESTABLISHED S1/4 COR SEC. 1 PRO-RATED TO US GLO (GEO.N.CANNON - 1851) BETWEEN FD SW S-1 & REESTABLISHED SE COR S-1.

M-3
REESTABLISHED SE COR OF S-1 ON LINE BETWEEN FD SW COR S-6 & NW COR S-6(T32N-R4E) & PRO-RATED DIST TO U.S. G.L.O, NORTH OF FD SW S-6. N. EDGE OF CEDAR SWP. IS 153'+/- NORTH. CTR OF E-W CO. RD. IS 553'+/- NORTH.

15
ESTABLISHED THE SW COR OF SE1/4 OF SW1/4 S-1 PER STANDARD BLM INSTRUCTIONS. CORNER FALLS IN CUT OVER AREA SMALL POPLAR BRUSH.

C. Description of monument for corner and accessories established to perpetuate locating the position of the corner:

L-3
SET DNR MON & CARSONITE POST.

4" W.PINE	S01°E	17.46'
5" W.PINE	S74°E	12.19'
5" MAPLE	N40°E	33.00'
5" W.PINE	N77°W	19.76'

M-3
SET 1"x 72" IR PIPE W/ALUMN DNR CAP & CARSONITE POST.

6" CEDAR	N02°E	5.14'
7" CEDAR	S87°E	12.35'
7" CEDAR	S17°E	8.80'
6" CEDAR	S73°W	9.19'

CTR SQD. ASH, 4"x 4" S-SW 0.9'
SW COR S-6, T32N-R4E, FD D.MARLATT IR,REPLACED W/DNR MON S01°28'09"E 232.94'

15
SET 5/8"x 32" REROD W/CAP & CARSONITE POST.

10" W.PINE	S36°E	70.14'
12" W.PINE	S60°W	73.70'
2" BALSAM	N32°W	20.91'
4" W.PINE	N10°E	30.58'

STATE OF MICHIGAN
CARL KIISKILA
LAND SURVEYOR
No. 33981
LICENSED LAND SURVEYOR

Signed by Carl T Kiiskila Date 2-27-97

Surveyor's Michigan License No. 33981

FORM APPROVED BY MICHIGAN STATE BOARD OF LAND SURVEYORS, JAN. 29, 1971
REVISED MAY 14, 1975
REVISED JAN., 1983