LAND CORNER RECORDATION CERTIFICATE

Filing Requirement of Act 74, Mich. P.A. 1970

For corners in MONTMORENCY
(County)

	Located In:	Corner Code ##
1. Public Land Survey	T 32N R 3E	M-2
	T ___ R ___	
	T ___ R ___	
	T ___ R ___	
2. Property Controlling	S 1 T ___ R ___	12, 14
In Section	S ___ T ___ R ___	
3. Miscellaneous	S ___ T ___ R ___	
Property in Sec.	S ___ T ___ R ___	

Register of Deeds Stamp & File Number

4. Lot No. _____ , Recorded Plat _____
5. Private Claims _____

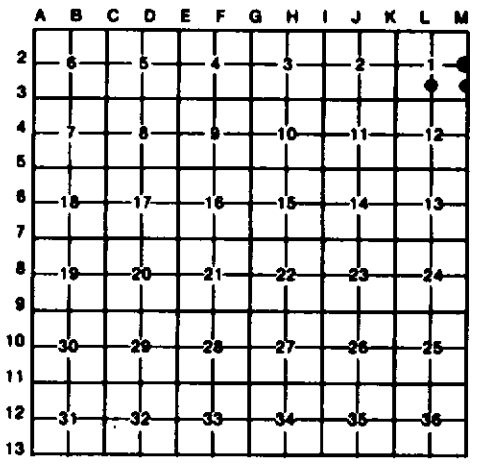

I, CARL KIISKILA, in a field survey on JUNE 10, 19 96, do hereby certify that under requirements of P.A. 74, Michigan P.A. of 1970, the corner points mentioned in lines 1 and 2 above were in conformance with regulations and rules therefore as required in the current manual of survey instructions of the United States Department of the Interior, Bureau of Land Management or by a decree of a Court of Law and/or that the corner points mentioned in lines 3, 4 and 5 above were in conformance with the rules of the Michigan Board of Land Surveyors or by a Decree of a Court of Law; established, re-established, monumented, re-monumented, recovered, found as expressed below:

NOTE: Not more than 4 corners, all in the same town and range, may be recorded on this certificate.

A. Description of original monument and accessories and/or subsequent restoration:

M-2 (NO EVIDENCE OF G.L.O. CORNER, B.T'S, LINE TREES & TOPOGRAPHY, AS CALLED OUT IN THE G.L.O. LINE NOTES; UNLESS NOTED IN ITEM "B" BELOW.)

12

14

B. Description of corner evidence found and/or method applied in restoring or reestablishing corner:

M-2: REESTABLISHED THE E1/4 COR S-1, SINGLE PROPORTION TO U.S. G.L.O. (GEO. H. CANNON-1851) RUNOUT BETWEEN FD SE & NE CORS OF S-1.

12: ESTABLISHED THE NE COR OF THE SE1/4 OF SW1/4 OF S-1 PER STANDARD BLM PROCEDURE.

14: ESTABLISHED THE SE COR OF THE FRL NE1/4 OF THE FRL SE1/4 OF S-1 PER STANDARD BLM PROCEDURES.

C. Description of monument for corner and accessories established to perpetuate locating the position of the corner:

M-2
SET DNR MON & CARSONITE POST.

7" CEDAR	S83°E	7.99'
8" CEDAR	S02°E	18.03'
8" CEDAR	S75°W	9.25'
8" SPRUCE	N05°W	28.18'

W1/4 COR S-6, T32N-R4E, SET DNR MON, S01°28'09"E 462.40'

12
SET 5/8"x 32" REROD W/PS CAP & CARSONITE POST.

4" W.PINE	S63°W	37.40'
6" W.PINE	N53°W	27.41'
10" W.PINE	N52°E	23.76'
5" R.PINE	SOUTH	14.08'

14
SET 5/8"x 32" REROD W/PS CAP & SET CARSONITE POST.

10" R.PINE	S50°E	29.08'
12" BALSAM	S11°W	5.26'
10" SPRUCE	N23°W	25.84'
4" SPRUCE	N35°E	16.69'

FENCE CORNER POST S65°W 7.7' (SMOOTH WIRE TO S & W)

STATE OF MICHIGAN
CARL KIISKILA
LAND SURVEYOR
No. 33981
LICENSED LAND SURVEYOR

Signed by Carl T. Kiiskila Date 2-27-97

Surveyor's Michigan License No. 33981

FORM APPROVED BY MICHIGAN STATE BOARD OF LAND SURVEYORS, JAN. 29, 1971
REVISED MAY 14, 1975
REVISED JAN., 1983