

SURVEY & REMONUMENTATION

APR 24 1995

LAND CORNER RECORDATION CERTIFICATE
Filing Requirement of Act 74, Mich. P.A. 1970

For corners in **COMMISSION**

STATE OF MICHIGAN
 MONTMORENCY COUNTY
 Recorded & Filed

<u>Montmorency</u> (County)	Located In: Montmorency Township	Corner Code # A-8
1. Public Land Survey	T <u>32 N</u> R <u>3 E</u>	<u>A-8</u>
	T _____ R _____	
	T _____ R _____	
	T _____ R _____	
2. Property Controlling in Section	S _____ T _____ R _____	
	S _____ T _____ R _____	
3. Miscellaneous Property in Sec.	S _____ T _____ R _____	
	S _____ T _____ R _____	

11-10-1994 14:13:36
 A. PANGAN-MCELROY
 REGISTER OF DEEDS

Register of Deeds Stamp & File Number

4. Lot No. _____, Recorded Plat _____
 5. Private Claims _____

I, Don Marlatt, in a field survey on November 8, 19 94, do hereby certify that under requirements of P.A. 74, Michigan P.A. of 1970, the corner points mentioned in lines 1 and 2 above were in conformance with regulations and rules therefore as required in the current manual of survey instructions of the United States Department of the Interior, Bureau of Land Management or by a decree of a Court of Law and/or that the corner points mentioned in lines 3, 4 and 5 above were in conformance with the rules of the Michigan Board of Land Surveyors or by a Decree of a Court of Law; established, re-established, monumented, re-monumented, recovered, found as expressed below:

NOTE: Not more than 4 corners, all in the same town and range, may be recorded on this certificate.

	A	B	C	D	E	F	G	H	I	J	K	L
2	6	5	4	3	2	1						
3												
4	7	8	9	10	11	12						
5												
6	18	17	16	15	14	13						
7												
8	19	20	21	22	23	24						
9												
10	30	29	28	27	26	25						
11												
12	31	32	33	34	35	36						
13												

A. Description of original monument and accessories and/or subsequent restoration:

- (A-B) W. $\frac{1}{4}$ Cor. Sec. 18, T 32 N, R 3 E
 Original corner set by Hiram Burnham July 1850, (Beech Post).
 12" Beech S 80° W 21 links
 12" Beech N 55° W 7 links
 Schaaf - DNR Survey - No Data.
 DNR Survey in Sec. 19, T 32 N, R 3 E in 1958 & 1989.
 DNR Land Corner Record Dated 11-17-58.
 D. Marlatt - Survey - 1-8-1990.


B. Description of corner evidence found and/or method applied in restoring or reestablishing corner:

- (A-B) W. $\frac{1}{4}$ Cor. Sec. 18, T 32 N, R 3 E
 Found DNR Monument - 1" pipe with 4" cap in road North and South.
 14" Oak N 65° W 32.93' (NBT)
 12" Maple S 46° W 35.55' (NBT)
 No evidence of original corner.
 Accepted as a careful and faithful establishment of the position of the corner.

C. Description of monument for corner and accessories established to perpetuate locating the position of the corner:

- (A-B) W. $\frac{1}{4}$ Cor. Sec. 18, T 32 N, R 3 E
 Left DNR Monument in place.
 12" Oak N 65° E 27.07'
 11" Oak S 67° E 32.91'
 14" Oak N 60° W 32.93' (NBT)
 12" Oak S 46° W 35.55' (NBT)

Witnesses marked with a 30 penny spike & I.D. tag #18660

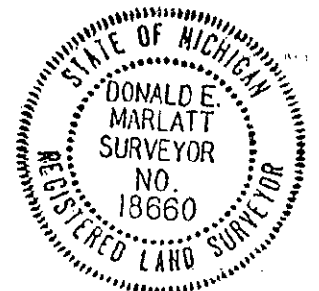

Signed by Donald E Marlatt Date 11-9-1994
 Surveyor's Michigan License No. 18660