

SURVEY & REMONUMENTATION Montmorency County Remonumentation

APR 24 1995

LAND CORNER RECORDATION CERTIFICATE
Filing Requirement of Act 74, Mich. P.A. 1970

Liber 00012 Page 0121

For corner **COMMISSION**

STATE OF MICHIGAN
MONTMORENCY COUNTY
Recorded & Filed

Montmorency (County) Located in Montmorency Twp. Corner Code #

11-02-1994 15:47:31

- 1. Public Land Survey T 32N R 3E (A-12)
- T R
- T R
- T R
- 2. Property Controlling S T R
- in Section S T R
- 3. Miscellaneous S T R
- Property in Sec. S T R

APPROVED BY PEER GROUP

A. PANGAN-MCELROY
REGISTER OF DEEDS

MAY 13 94

Register of Deeds Stamp & File Number

- 4. Lot No. _____, Recorded Plat _____
- 5. Private Claims _____

I, Larry G. Beauregard in a field survey on March, 19 94, do hereby certify that under requirements of P.A. 74, Michigan P.A. of 1970, the corner points mentioned in lines 1 and 2 above were in conformance with regulations and rules therefore as required in the current manual of survey instructions of the United States Department of the Interior, Bureau of Land Management or by a decree of a Court of Law and/or that the corner points mentioned in lines 3, 4 and 5 above were in conformance with the rules of the Michigan Board of Land Surveyors or by a Decree of a Court of Law; established, re-established, monumented, re-monumented, recovered, found as expressed below:

	A	B	C	D	E	F	G	H	I	J	K	L	M
2	6	5	4	3	2	1							
3													
4	7	8	9	10	11	12							
5													
6	18	17	16	15	14	13							
7													
8	19	20	21	22	23	24							
9													
10	30	29	28	27	26	25							
11													
12	31	32	33	34	35	36							
13													


NOTE: Not more than 4 corners, all in the same town and range, may be recorded on this certificate.

A. Description of original monument and accessories and/or subsequent restoration:

A-12) GLO post set by Hiram Burnham July 4, 1850.
Wits: Aspen 6" N 60° W 38 links W. Birch 4" S 65° W 32 links
Ken Ostling P.S. #10068 in 1958 found 2" pipe in place, in line with 1/4 line road West. Filed Forestry Division Land Corner Record.
Witnesses marked: (12" Y. Pine stp. N 16° W 92' links [Old NBT]) (18" Y. Pine stp. S 88° E 123 links [Old NBT]).
Note: This corner was found by Forestry Division survey crew while making a survey in this area. Found a 2" pipe in place, in line with 1/4 line road West. Cannot identify small Gov't. B.T.'s but it is said by residents that corner has been in place for at least 23 years, and so was used to control survey of town line.

B. Description of corner evidence found and/or method applied in restoring or reestablishing corner:

A-12) Found 2" pipe in a 8" square concrete block in line with 1/4 line road West and witnesses by Ostling. (DOC standard corner).
Re-placed 2" pipe with 4" x 36" concrete monument and a 3" diameter aluminum cap marked Montmorency County Remonumentation Corner.

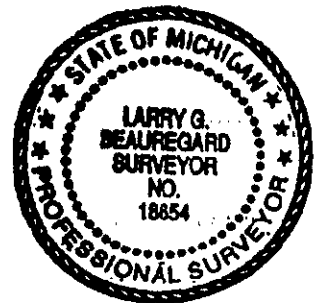

C. Description of monument for corner and accessories established to perpetuate locating the position of the corner:

A-12) 1/4 Cor. Comm. to Sec's 31 & 36, T32N, R2E, & T32N, R3E.
4" x 36" concrete monument & remonumentation cap #18654, accepted as the best available evidence of the re-establishment of the original corner. Approved by the Peer Group on May 13, 1994.

- N 16° W 60.72' (R) 61.54' (M) P.S. tag #15410 12" Y. Pine stump (Old NBT)
- S 88° E 81.18' (R) 81.94' (M) P.S. tag #15410 18" Y. Pine stump (Old NBT)
- N 75° E 118.8' 20" Norway S 05° E 64.54' 5" Norway
- S 25° W 52.17' 6" Norway S 80° W 35.00' 17" Norway

Placed blaze, 20 penny spike & P.S. tag #18654 (typ)

Signed by Larry G. Beauregard Date 11/2/94
Surveyor's Michigan License No. 18654