CORNER MONUMENT


MICHIGAN DEPARTMENT OF CONSERVATION FORESTRY DIVISION

LAND CORNER RECORD

	TT.	30-32 N.R. 30-32 N.R. 31 N.R.	3 E	Montmorency	COUNTY
DESCRIPTION OF CORNER	Township corner	common to	sections l	· · · · · ·	

DATE MONUMENT PLACED AND WITHESSED May 13, 1966

Set 1" pipe with h" aluminum cap

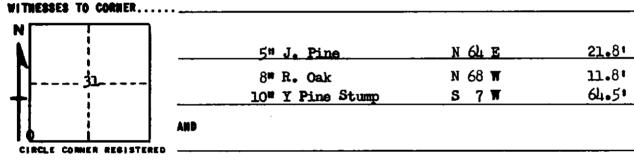

DESCRIPTION IN DETAIL AS TO NOW CORNER WAS LOCATED AND IDENTIFIED OR RESTORED.

This corner was found while making a survey of Section 30. Found 1" pipe buried at corner. USBTs by Ives in place showing good face and scribe marks. Set this corner to perpetuate good government corner, and to control other surveys.

SURVEYOR'S SEAL

SIGNED Lewelly Polling
REGISTERES LAND SURVEYOR #10068

DATE May 17, 1966