
Coss. 4047 REV. 10/60

MICHIGAN DEPARTMENT OF CONSERVATION FORESTRY DIVISION

LAND CORNER RECORD

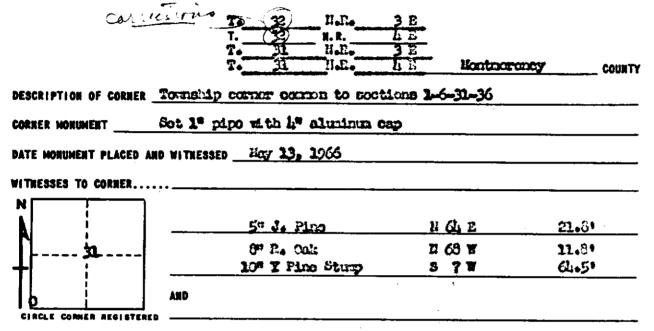

DESCRIPTION IN DETAIL AS TO NOW CORNER WAS LOCATED AND IDENTIFIED OR RESTORED.

This corner was found while making a survey of Section 30. Found 1" pipe buried at corner. USDIs by Ives in place chaming good face and scribe marks. Set this corner to perpetuate good government corner, and to control other surveys.

SURVEYOR'S SEAL

SIGNED	_	DATE_	Hay	17,	1966
	REGISTERED LAND SURVEYOR \$30068				