LAND CORNER RECORDATION CERTIFICATE

Filing Requirement of Act 74, Mich. P.A. 1970

For corners in MONTMORENCY (County)

	Located In:	Corner Code ##
1. Public Land Survey	T 32N R 4E	B-3
	T ___ R ___	
	T ___ R ___	
	T ___ R ___	
2. Property Controlling	S 7 T ___ R ___	1, 2
in Section	S ___ T ___ R ___	
3. Miscellaneous	S ___ T ___ R ___	
Property in Sec.	S ___ T ___ R ___	

Register of Deeds Stamp & File Number

4. Lot No. _____ , Recorded Plat _____
5. Private Claims _____

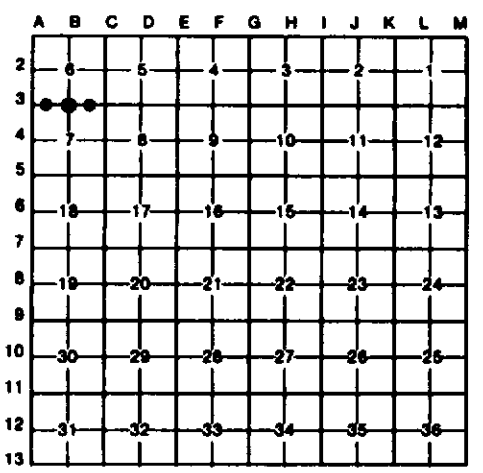

I, CARL KIISKILA, in a field survey on AUGUST 15, 19 96, do hereby certify that under requirements of P.A. 74, Michigan P.A. of 1970, the corner points mentioned in lines 1 and 2 above were in conformance with regulations and rules therefore as required in the current manual of survey instructions of the United States Department of the Interior, Bureau of Land Management or by a decree of a Court of Law and/or that the corner points mentioned in lines 3, 4 and 5 above were in conformance with the rules of the Michigan Board of Land Surveyors or by a Decree of a Court of Law; established, re-established, monumented, re-monumented, recovered, found as expressed below:

NOTE: Not more than 4 corners, all in the same town and range, may be recorded on this certificate.

A. Description of original monument and accessories and/or subsequent restoration:

B-3

(NO EVIDENCE OF G.L.O. CORNER, B.T'S, LINE TREES & TOPOGRAPHY, AS CALLED OUT IN THE G.L.O. LINE NOTES; UNLESS NOTED IN ITEM "B" BELOW.)

1

2

B. Description of corner evidence found and/or method applied in restoring or reestablishing corner:

B-3

REESTABLISHED THE N1/4 COR OF SEC 7 PRO-RATED TO US GLO RUNOUT BETWEEN FOUND NW & NE COR'S OF SEC 7. THIS POSITION FITS REASONABLE TO WORK DONE IS S-7 BY D.MARLATT, Li.3, Pg.580.

1

ESTABLISHED THE NE COR OF THE FRL. NW1/4 OF FRL. NW1/4 OF SED. 7 PER STANDARD BLM PROCEDURE(PRO-RATED TO US GLO RUNOUT).

2

ACCEPTED FOUND 1/2" REROD BY D. MARALATT FOR NE COR OF NW1/4 OF NE1/4 OF SEC S-7.

C. Description of monument for corner and accessories established to perpetuate locating the position of the corner:

B-3

SET 1"x 32" PIPE W/DNR ALUMN CAP & CARSONITE POST.

10" MAPLE	S54°W	9.31'
6" MAPLE	S42°E	12.46'
4" OAK	N68°E	15.19'
4"BALSAM	N24°W	27.78'

1

SET 1"x 60" IRON PIPE W/PS CAP & CARSONITE POST W/LDC TAG.

16" W.PINE	N45°E	16.07'
7" CEDAR	S08°E	24.64'
6" CEDAR	S75°W	10.37'
8" CEDAR	N04°W	26.02'

2

FOUND 1/2" REROD W/CAP, PLACED A 1"x 60" PIPE OVER REROD W/CAP & SET CARSONITE POST.

6" SPRUCE	SOUTH	10.87'
4" CEDAR	S51°W	12.11'
12" CEDAR	S54°E	7.86'
8" MAPLE	N08°W	23.08'
‡5" CEDAR	N30°E	5.18'

‡= OLD WIT BY OTHERS

STATE OF MICHIGAN
CARL KIISKILA
LAND SURVEYOR
No. 33981
LICENSED LAND SURVEYOR

Signed by Carl T. Kiiskila Date 2-27-97

Surveyor's Michigan License No. 33981

FORM APPROVED BY MICHIGAN STATE BOARD OF LAND SURVEYORS, JAN. 28, 1971
REVISED MAY 14, 1975
REVISED JAN., 1983