LAND CORNER RECORDATION CERTIFICATE

Filing Requirement of Act 74, Mich. P.A. 1970

For corners in MONTMORENCY (County)

	Located In:	Corner Code ##
1. Public Land Survey	T 32N R 4E	A-4
	T ___ R ___	
	T ___ R ___	
	T ___ R ___	
2. Property Controlling	S 7 T ___ R ___	3, 10
In Section	S ___ T ___ R ___	
3. Miscellaneous	S ___ T ___ R ___	
Property in Sec.	S ___ T ___ R ___	

Register of Deeds Stamp & File Number

4. Lot No. _____ , Recorded Plat _____
5. Private Claims _____

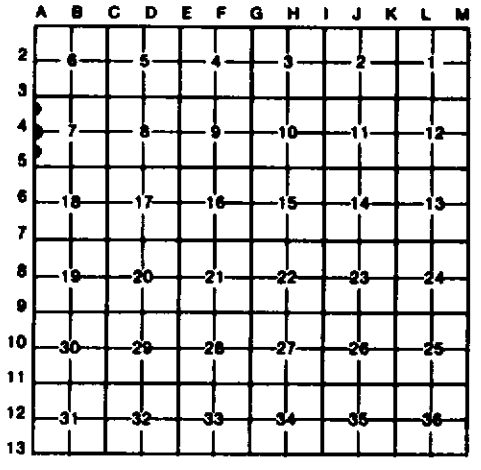

I, CARL KIISKILA, in a field survey on AUGUST 28, 19 96, do hereby certify that under requirements of P.A. 74, Michigan P.A. of 1970, the corner points mentioned in lines 1 and 2 above were in conformance with regulations and rules therefore as required in the current manual of survey instructions of the United States Department of the Interior, Bureau of Land Management or by a decree of a Court of Law and/or that the corner points mentioned in lines 3, 4 and 5 above were in conformance with the rules of the Michigan Board of Land Surveyors or by a Decree of a Court of Law; established, re-established, monumented, re-monumented, recovered, found as expressed below:

NOTE: Not more than 4 corners, all in the same town and range, may be recorded on this certificate.

A. Description of original monument and accessories and/or subsequent restoration:

A-4 (NO EVIDENCE OF G.L.O. CORNER, B.T'S, LINE TREES & TOPOGRAPHY, AS CALLED OUT IN THE G.L.O. LINE NOTES; UNLESS NOTED IN ITEM "B" BELOW.)

3

10

B. Description of corner evidence found and/or method applied in restoring or reestablishing corner:

A-4
REESTABLISHED THE N1/4 COR OF SEC 7 PRO-RATED TO US- GLO (GEO.H CANNON 1851) RUNOUT, BETWEEN FD SW COR & NW COR OF SEC 7 FOR LAT. & ON LINE BETWEEN FD SW COR S-7 & FD CEDAR STAKE FOR E1/4 COR S-12, T32N-R3E (SAID E1/4 COR S-12 IS N00°35'11"W, 230.36').

3
ESTABLISHED THE SW COR OF THE FRL NW1/4 OF FRL NW1/4 OF SEC. 7 PER STANDARD BLM PROCEDURE.

10
ESTABLISHED THE NW COR OF THE FRL SW1/4 OF THE FRL SW1/4 OF SEC 7 PER STANDARD BLM PROCEDURE.

C. Description of monument for corner and accessories established to perpetuate locating the position of the corner:

A-4
SET 1"x 32" PIPE W/DNR ALUMN CAP & CEDAR POST.

12" MAPLE	N19°W	22.21'
10" CEDAR	S72°E	24.64'
10" HEMLOCK	S03°E	24.49'
6" SPRUCE	N78°W	24.47'

N-S SMOOTH WIRE WEST 3'+/-
CORNER FALLS IN LARGE ROOT OF CEDAR TREE, REMOVED 1' LENGTH OF ROOT TO SET MON.

3
SET 5/8"x 32" REROD W/PS CAP & STEEL FENCE POST.

5" MAPLE	N45°E	17.04'
5" W.PINE	N06°W	11.80'
3" W.PINE	S83°W	34.29'
16"W.BIRCH	S39°E	8.99'
CTR FN COR POST	N75°E	2.85'

(SMOOTH WIRE N-S & E)

10
SET 5/8"x 32" REROD W/PS CAP & SET CEDAR POST.

4" MAPLE	N22°E	1.52'
8" CEDAR	S60°E	20.58'
7" SPRUCE	S13°E	14.26'
6" CEDAR	S82°W	5.99'

SMOOTH WIRE E & W IS SOUTH 46'+/-.

STATE OF MICHIGAN
CARL KIISKILA
LAND SURVEYOR
No. 33981
LICENSED LAND SURVEYOR

Signed by Carl T. Kiiskila Date 2-27-97

Surveyor's Michigan License No. 33981

FORM APPROVED BY MICHIGAN STATE BOARD OF LAND SURVEYORS, JAN. 28, 1971
REVISED MAY 14, 1975
REVISED JAN., 1983