

1993

NEWAYGO COUNTY
1993 NEWAYGO COUNTY REMONUMENTATION PROJECT DEEDS

REGISTERED
MARLENE TOOGOOD

COMMISSION

LAND CORNER RECORDATION CERTIFICATE

Filing Requirement of Act 74, Mich. P.A. 1970

JAN 21 PM 3 25 '94

For corners in
Newaygo

(County)	Located In:	Corner Code #:
1. Public Land Survey	T <u>11N</u> R <u>11W</u>	A-1
	T _____ R _____	_____
	T _____ R _____	_____
	T _____ R _____	_____
2. Property Controlling in Section	S _____ T _____ R _____	_____
	S _____ T _____ R _____	_____
3. Miscellaneous Property in Sec.	S _____ T _____ R _____	_____
	S _____ T _____ R _____	_____

Marlene Toogood

VOL 001 PAGE 07

Register of Deeds Stamp & File Number

- 4. Lot No. _____, Recorded Plat _____
- 5. Private Claims _____

A	B	C	D	E	F	G	H	I	J	K	L	M
2	6	5	4	3	2	1						
3												
4	7	8	9	10	11	12						
5												
6	18	17	16	15	14	13						
7												
8	19	20	21	22	23	24						
9												
10	30	29	28	27	26	25						
11												
12	31	32	33	34	35	36						
13												

I, Norman L. Ochs, in a field survey on October 16, 19 93, do hereby certify that under requirements of P.A. 74, Michigan P.A. of 1970, the corner points mentioned in lines 1 and 2 above were in conformance with regulations and rules therefore as required in the current manual of survey instructions of the United States Department of the Interior, Bureau of Land Management or by a decree of a Court of Law and/or that the corner points mentioned in lines 3, 4 and 5 above were in conformance with the rules of the Michigan Board of Land Surveyors or by a Decree of a Court of Law; established, re-established, monumented, re-monumented, recovered, found as expressed below:

NOTE: Not more than 4 corners, all in the same town and range, may be recorded on this certificate.

NW. Corner of Section 6, Ensley Twp., Newaygo County, Michigan

A. Description of original monument and accessories and/or subsequent restoration:

G.L.O. 8" Birch S52°W 8 links 12" Birch S31°W 13 Links NCRC Sheet 1934 Leaf of Spring 6" W. Birch S35°E 62.2' 4" Burr Oak S30°W 61.1'	Newaygo Eng. & Survey Co. Nov. 24, 1976 10-12" Tw. Red Oak S75°W 76.19' P. Pole N27°E 77.29' 5" W. Pine S61°E 63.04'	Steve Vallier RLS #28428 1989 Found 1/2" iron rod Found Leaf Spring 24" W. Pine N30°W 39.24' Power Pole N30°E 77.20' 18"-24" Tw. Oak S72°W 75.86' Also see L. 349, Pg. 461
---	---	---


B. Description of corner evidence found and/or method applied in restoring or reestablishing corner:

Found Leaf Spring and 1/2" Rod above over
Found Original Wood Post remnant ± 7" long and ± 3 feet deep in old muck
and Set a 4" Harrison Cast Iron Monument 16" long at position of the original wood post
Condition of recorded witnesses is:
20"-18" Tw. B. Oak S75°W 75.80' spike on the North side
20" W. Pine N30°W 39.20' spike on the East side
Power Pole N27°E 77.43' spike on the East side
14" Burr Oak S30°W 61.08' spike on the SE. side
#1 Gone, #2 Gone, #3 Gone, #7 Gone.

C. Description of monument for corner and accessories established to perpetuate locating the position of the corner:

Newaygo Engineering and Survey Co. Removed old iron & wood post.
Set 4" Harrison Cast Iron Monument 16" long
for sec. cor. and is accepted as a careful & faithful
20"-18" Tw. B. Oak S75°W 75.80' spike on the North side #10.
Power Pole N27°E 77.43' spike on the East side #6
18" W. Pine S61°E 63.49' spike on the West side #7
20" W. Pine N30°W 39.20' spike on the East side #8
14" Burr Oak S30°W 61.08' spike on the SE. side #4

position of the original marker.

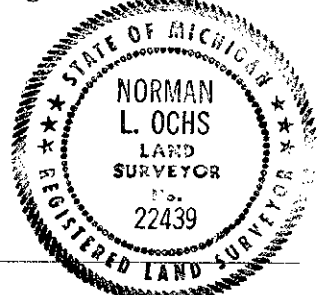

Signed by Norman L. Ochs Date November 8, 1993
Surveyor's Michigan License No. #22439

Approved by Peer Review Group Nov. 9, 1993
Norman L. Ochs, County Representative