

1993

COMMISSION

1993 NEWAYGO COUNTY REMONUMENTATION PROJECT

NEWAYGO COUNTY REGISTER OF DEEDS MARLENE TOGGOOD

'94 JAN 21 PM 3 25

Marlene Toggood

VOL 001 PAGE 08

LAND CORNER RECORDATION CERTIFICATE Filing Requirement of Act 74, Mich. P.A. 1970

For corners in

Table with columns: Newaygo (County), Located In, Corner Code #. Rows include Public Land Survey, Property Controlling in Section, and Miscellaneous Property in Sec.

Register of Deeds Stamp & File Number

4. Lot No. Recorded Plat
5. Private Claims

W-1/4 Corner, Section 6, Ensley Township.

Norman L. Ochs in a field survey on October 16, 1993

do hereby certify that under requirements of P.A. 74, Michigan P.A. of 1970, the corner points mentioned in lines 1 and 2 above were in conformance with regulations and rules therefore as required in the current manual of survey instructions of the United States Department of the Interior, Bureau of Land Management or by a decree of a Court of Law and/or that the corner points mentioned in lines 3, 4 and 5 above were in conformance with the rules of the Michigan Board of Land Surveyors or by a Decree of a Court of Law; established, re-established, monumented, re-monumented, recovered, found as expressed below:

NOTE: Not more than 4 corners, all in the same town and range, may be recorded on this certificate.

W. 1/4 Corner, Section 6, Ensley Twp., Newaygo County, Michigan

A. Description of original monument and accessories and/or subsequent restoration:

- G.L.O. Newaygo Eng. & Survey Co. Advanced Survey - Map 1990
8" Maple S22°W 21 links #1 Dec. 01, 1976
8" Maple N68°W 37 links #2 Set 1/2" Rod
12" Cherry N60°E 33.25' #3
10" R. Oak N61°W 17.83' #4
18" Forked W. Oak S08°E 51.88' #5
1/2" Iron - Found.
16" Cherry N60°E 33.30' #6
24" Oak S08°E 51.88' #7
Power Pole S52°W 43.15' #8
#5 8/2/89 Steve Vallier RLS #2842 Found same as above. See also L. 349, Pg. 461.

B. Description of corner evidence found and/or method applied in restoring or reestablishing corner:


Newaygo Eng. & Survey Company in 1976 could not find evidence of either the corner monument or of bearing trees. Newaygo Eng. & Survey Co. reestablished the location of corner by single proportional measurement (2640.30 ft. & 2640.30 ft) on a straight line between the SW corner and the NW corner of Section 6, T11N, R11W. Found 1/2" rod and cap.

Condition of recorded witness is: #1 gone, #2 gone, #3 found in good condition, #4 gone, #5 found in good condition, #6 found in good condition, #7 found in good condition, #8 found in good condition.

C. Description of monument for corner and accessories established to perpetuate locating the position of the corner:

Removed 1/2" rod and cap and set 4" dia. cast iron Harrison Monument and is accepted as a careful and faithful reestablishment of the position of the original corner.

- 15" Cherry N60°E 33.30' (Spike in N. side of tree) #3, #6
24" Forked W. Oak S08°E 51.86' (Spike in E side of tree) #5, #7.
P.Pole S52°W 43.16' (PK nail in S side of Pole) #8.
20" W. Oak N52°W 47.49' (Spike in S. side of tree).

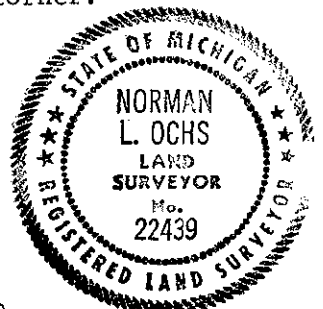

Signed by Norman L. Ochs

Date November 8, 1993

Surveyor's Michigan License No. 22439

Approved by Peer Review Group Nov. 9, 1993
Norman L. Ochs, County Representative