

**SURVEY &
REMONUMENTATION**

1995 Newaygo County Remonumentation Project

APR 04 1996

LAND CORNER RECORDATION CERTIFICATE
FILING REQUIREMENT of Act 74, Mich. P.A. 1970

1995 FEB 21 AM 9:36

COMMISSION

Marlene Toogood

For corners in <u>Newaygo</u> (County)	Located in:	Corner Code #
1. Public Land Survey	T <u>11N</u> R <u>11W</u>	<u>C-7</u>
	T ___ R ___	_____
	T ___ R ___	_____
	T ___ R ___	_____
2. Property Controlling in Section	S ___ T ___ R ___	_____
	S ___ T ___ R ___	_____
3. Miscellaneous Property in Sec.	S ___ T ___ R ___	_____
	S ___ T ___ R ___	_____
4. Lot No. _____, Recorded Plat _____		
5. Private Claims _____		

VOL. 1 PAGE 153

Register of Deeds Stamp & File Number

A	B	C	D	E	F	G	H	I	J	K	L	M
2	6	5	4	3	2	1						
3												
4	7	8	9	10	11	12						
5												
6	18	17	16	15	14	13						
7												
8	19	20	21	22	23	24						
9												
10	30	29	28	27	26	25						
11												
12	31	32	33	34	35	36						
13												

I, Norman L. Ochs, in a field survey on September 30, 1995, do hereby certify that under requirements of P. A. 74, Michigan P.A. of 1970, the corner points mentioned in lines 1 and 2 above were in conformance with regulations and rules therefore as required in the current manual of survey instructions of the United States Department of the Interior, Bureau of Land Management or by a decree of a Court of Law and/or that the corner points mentioned in lines 3, 4 and 5 above were in conformance with the rules of the Michigan Board of Land Surveyors or by a Decree of a Court of Law; established, re-established, monumented, re-monumented, recovered, found as expressed below:

Note: Not more than 4 corners, all in the same town and range, may be recorded on this certificate.

N.W. Corner, Section 20, Ensley Twp., Newaygo Co., MI

A. DESCRIPTION OF ORIGINAL MONUMENT AND ACCESSORIES AND/OR SUBSEQUENT RESTORATION:

G.L.O. James H. Mullett 1837
12" Birch S57°E 31Lks (20.46')#1
12" Maple S81°W 24Lks (15.84')#2

William M Jacques (Co. Surveyor)
Book 1 Pg's 10 & 11 at Reg. of Deeds May 15, 1903
Book A Pg. 381 Book 9 Pg. 21 Book A Pg. 379
Iron corner with stone on top of iron and X on stone
Measured 39.76 ch (2624.16 ft) from the N.W. Cor. to the N. ¼ Cor. of Sec. 20 and measured 40.28 ch (2658.48 ft) from the N.W. Cor. to the W. ¼ Cor. of Sec. 20 and measured 41.9 ch (2765.40 ft) from the N.E. Cor. to the N. ¼ Cor. of Section 19

W.S. Merrill (Co. Surveyor)
Book A Pg's 77 & 78 September 28, 1882
36" Pine N72½°E 21Lks (13.86')#3
40" Pine S42°W 41½Lks (27.39')#4

William M. Jacques (Co. Surveyor)
May 16, 1911 Book 11 Pg's 20 & 21
Measured 40.01½ ch (2640.99 ft) from the S.E. Cor. to the E ¼ Cor. of Sec. 18 and measured 40.16 ch (2650.56 ft) from the SE Cor. to the S. ¼ Cor. of Sec. 18

William M. Jacques (Co. Surveyor)
Book 1 Pg's 12 & 13 at Reg. of Deeds August 12, 1904
Found corner set by W.S. Merrill-set a large stone for Cor. with a X cut on top of stone and glass buried around stone
Measured 40.19 ch (2652.54 ft) from the N.E. Cor. to the N. ¼ Cor. of Sec. 19 and measured 40 ch 18 8/12 ft (2658.67 ft) from the N.E. Cor. to the E. ¼ Cor. of Sec. 19

OVER ↘

B. DESCRIPTION OF CORNER EVIDENCE FOUND AND/OR METHOD APPLIED IN RESTORING OR REESTABLISHING CORNER:

Found ½" rod on top of ½" iron 2 ft deep, this in a fill area in the centerline of roads going North and South and East and West and measured 2620.07 ft from the N.W. Cor. to the N. ¼ Cor. and measured 2654.63 ft from the N.W. Cor. to the W. ¼ Cor. of Sec. 20 and the condition of the recorded witnesses are: #1 thru #5 gone, #6 good condition, #7 gone, #8 good condition, #9 is not a maple as called for by Hackbardt and Meyer #10 good condition.

C. DESCRIPTION OF MONUMENT FOR CORNER AND ACCESSORIES ESTABLISHED TO PERPETUATE LOCATING THE POSITION OF THE CORNER:

Removed ½" rod and set a 4" dia. Harrison cast iron monument 20" long marked "County Surveyor" on top of ½" iron as a substantial marker for the section corner and is a careful and faithful reestablishment of the original corner.


- 36" Maple S43°E 41.61' Spike in Southwest side of tree. #6
- P. Pole N45°W 80.10' Spike in Southwest side of pole. #8
- 22" Cherry S45°W 45.43' Spike in the Northwest side of tree. #9
- 8" Poplar S20°W 71.95' Spike and brass washer in East side of tree. #10

Signed by *Norman L. Ochs* Date October 2, 1995
Norman L. Ochs

Surveyor's Michigan License No. 22439

Form approved by Michigan State Board of Land Surveyors, Jan 28, 1971
Revised May 14, 1975
Revised Jan., 1983

Approved by Peer Review Group On October 3, 1995
Norman L. Ochs, County Representative. *N.L.O.*

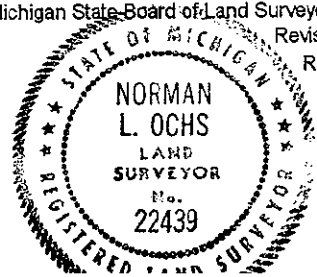

A. Description (Continued)

Lyle S. Shepherd RLS #503
Book B Pg's 76 & 77 July 7, 1917

Square stone

30" Stump N.W. 30.5' #5

10" Maple S.E. 42' #6

Measured 2637.3 ft from the S.W. Cor. to the W. ¼ Cor. of Sec. 17 and measured 2618.4 ft from the S.W. Cor. to the S. ¼ Cor. of Sec. 17

NCRC Sheet

½" Iron

40" Group Elm S45°W 30.3' #7

28" Maple S45°E 41.8' #6

Measured 2625.5 ft from the N.E. Cor. to the N. ¼ Cor. of Sec. 19 and measured 2619.6 ft from the N.W. Cor. to the N. ¼ Cor. of Sec. 20

Newaygo Engineering and Survey Co.

Nov. 4, 1985 Found ½" Rod

30" Maple S45°E 41.76' #6

P. Pole N45°W 80.12' #8

14" Cherry S45°W 45.39' #9

Measured 2651.29 ft from the S. ¼ Cor. to the S.E. Cor. of Sec. 18

Glen S. Hackbardt RLS #25844

LCRC #755 March 10, 1986

Found ½" Rod at centerline "X"

24" Maple S45°W 45.4' #9

40" Maple S45°E 41.8' #6

C.P. N40°W 80' #8

Allan L. Meyer RLS #15406

LCRC #1012 February 1990

Found ½" rod at centerline "X"

40" Maple S45°E 41.80' #6

24" Maple S45°W 45.38' #9

P. Pole N40°W 80.10' #8

8" Poplar S20°W 71.96' #10