

**SURVEY &
REMONUMENTATION**

1995 Newaygo County Remonumentation Project

APR 04 1996

**LAND CORNER RECORDATION CERTIFICATE
FILING REQUIREMENT of Act 74, Mich. P.A. 1970**

NEWAYGO COUNTY
REGISTER OF DEEDS
MARLENE F000000

COMMISSION

For corners in <u>Newaygo</u> (County)	Located in:	Corner Code #
1. Public Land Survey	T <u>11</u> N R <u>11</u> W	<u>C-8</u>
	T ___ R ___	_____
	T ___ R ___	_____
	T ___ R ___	_____
2. Property Controlling in Section	S ___ T ___ R ___	_____
	S ___ T ___ R ___	_____
3. Miscellaneous Property in Sec.	S ___ T ___ R ___	_____
	S ___ T ___ R ___	_____
4. Lot No. _____, Recorded Plat _____		
5. Private Claims _____		

96 FEB 21 AM 9 37

Moskora Trogoff

VOL. 1 PAGE 154

Register of Deeds Stamp & File Number

	A	B	C	D	E	F	G	H	I	J	K	L	M
2	6	5	4	3	2								
3													
4	7	8	9	10	11	12							
5													
6	10	17	16	15	14	13							
7													
8	19	20	21	22	23	24							
9													
10	30	29	28	27	26	25							
11													
12	31	32	33	34	35	36							

I, Norman L. Ochs, in a field survey on September 30, 1995, do hereby certify that under requirements of P. A. 74, Michigan P.A. of 1970, the corner points mentioned in lines 1 and 2 above were in conformance with regulations and rules therefore as required in the current manual of survey instructions of the United States Department of the Interior, Bureau of Land Management or by a decree of a Court of Law and/or that the corner points mentioned in lines 3, 4 and 5 above were in conformance with the rules of the Michigan Board of Land Surveyors or by a Decree of a Court of Law; established, re-established, monumented, re-monumented, recovered, found as expressed below:

Note: Not more than 4 corners, all in the same town and range, may be recorded on this certificate.

W. 1/4 Corner, Section 20, Ensley Twp., Newaygo Co., MI

A. DESCRIPTION OF ORIGINAL MONUMENT AND ACCESSORIES AND/OR SUBSEQUENT RESTORATION:

G.L.O. James H. Mullett 1837 18" Sugar N84°W 11Lks (7.26')#1 24" W. Oak N80°E 26Lks (17.16')#2	William M. Jacques (Co. Surveyor) Book 1 Pg's 10 & 11 Reg. of Deeds May 15, 1903 Book A Pg's 379 & 381 Corner marked by long pointed stone and original bearings Measured 40.28 ch (2658.48 ft) from the W. 1/4 Cor. to the N.W. Cor. of Sec. 20 and measured 39.83 ch (2628.78 ft) from the W. 1/4 Cor. to the C. 1/4 Cor. of Sec. 20 and measured 40.26 ch (2657.16 ft) from the W. 1/4 Cor. to the S.W. Cor. of Sec. 20 and measured 40.14 ch (2649.24 ft) from the E. 1/4 Cor. to the C. 1/4 Cor. of Sec. 19
W.S. Merrill (Co. Surveyor) Book A Pg's 77 & 78 September 28, 1882 Measured 39.63 ch (2615.58 ft) from the W. 1/4 Cor. to the C. 1/4 Cor. of Sec. 20	Ralph A. Smith RLS #3421 Book 70 Pg's 144 & 145 June 26, 1953 Found Iron-Blue stone 5" Elm N85±°W 33.0' #3 6" W. Oak S60±°E 34.9' #4
William M. Jacques (Co. Surveyor) Book 1 Pg's 12 & 13 Reg. of Deeds August 12, 1904 Found original bearings-set stone for corner with X cut on top. Measured 40 ch 18 8/12 ft (2658.67 ft) from the N.E. Cor. to the E. 1/4 Cor. of Sec. 19 and measured 40.14 ch (2649.24 ft) from the E. 1/4 Cor. to the C. 1/4 Cor. of Sec. 19 and measured 40 ch 17 1/2 ft (2657.5 ft) from the E. 1/4 Cor. to the S.E. Cor. of Sec. 19	

OVER ↴


B. DESCRIPTION OF CORNER EVIDENCE FOUND AND/OR METHOD APPLIED IN RESTORING OR REESTABLISHING CORNER:

Found 1" solid iron rod 18" long and large blue stone on its side next to it with smaller stones all around and very old wood stake, on tree line East and West and fence line and centerline of road North is 4 ft East and measured 2654.63 ft from the N.W. Cor. to the W. 1/4 Cor. and measured 2637.71 ft from the W. 1/4 Cor. to the S.W. Cor. of Sec. 20 and the condition of the recorded witness are: #1 thru #4 gone, #5 thru #9 good condition.

C. DESCRIPTION OF MONUMENT FOR CORNER AND ACCESSORIES ESTABLISHED TO PERPETUATE LOCATING T POSITION OF THE CORNER:

Removed 1" solid iron rod and large blue stone and old wood stake and set a 4" dia. Harrison cast iron monument 20" long marked "County Surveyor" as a substantial marker for the section corner and is accepted as a careful and faithful reestablishment of the original corner.

Top center tele. ped. #12404 S64°E 35.83' #5
P. Pole S29°E 124.88' #6
Nail and tag in ground S25°E 157.04' #7
Nail and tag in ground S25°E 192.45' #8
3"-6"-8"-12" Multi Maple S56°W 53.59' Nail in root also 53.74' to spike and brass washer on Northwest side. #9
10" Ash N87°W 25.35' Spike in North side of tree.
16" Elm N90°E 75.28' Spike in South side of tree.

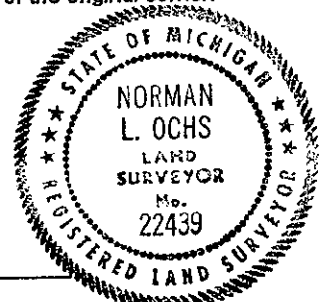

Signed by Norman L. Ochs Date October 2, 1995

Surveyor's Michigan License No. 22439

Form approved by Michigan State Board of Land Surveyors, Jan 28, 1971
Revised May 14, 1975
Revised Jan., 1983

Approved by Peer Review Group On October 3, 1995
Norman L. Ochs, County Representative. *N.L.O.*

A. Description (Continued)

NCRC Sheet

Iron

5" Elm N85°W 33.0' #3

6" W. Oak S60°E 34.9' #4

William Fries Jr. PS #30389

LCRC #1154 September 6, 1991

Found Iron in occupied centerline road N-S and in tree row
to East and occupation to West.

1/4" Iron

Top centerline Tele. Ped. "12404" AZ116° 36.06' #5

P. Pole AZ151° 124.88' #6

Nail and tag in ground AZ155° 157.04' #7

Nail and tag in ground AZ155° 192.45' #8

3"-5"-5"-9" Multi Maple AZ233° 53.59' #9