

MAR 13 2000

1999 Newaygo County Remonumentation Project

NEWAYGO COUNTY REGISTER OF DEEDS LINDA M. BROWN

SECTION

LAND CORNER RECORDATION CERTIFICATE
FILING REQUIREMENT of Act 74, Mich. P.A. 1970

FEB 28 PM 1 09

For corners in <u>Newaygo</u> (County)	Located in:	Corner Code #
1. Public Land Survey	T <u>11N</u> R <u>11W</u>	<u>D-13</u>
	T ___ R ___	_____
	T ___ R ___	_____
	T ___ R ___	_____
2. Property Controlling in Section	S ___ T ___ R ___	_____
	S ___ T ___ R ___	_____
3. Miscellaneous Property in Sec.	S ___ T ___ R ___	_____
	S ___ T ___ R ___	_____
4. Lot No. _____, Recorded Plat _____		
5. Private Claims _____		

Linda M. Brown

VOL. 2

281

Register of Deeds Stamp & File Number

	A	B	C	D	E	F	G	H	I	J	K	L	M
1													
2	6		5		4		3		2		1		
3													
4	7		8		9		10		11		12		
5													
6	18		17		16		15		14		13		
7													
8	19		20		21		22		23		24		
9													
10	30		29		28		27		26		25		
11													
12	31		32		33		34		35		36		
13													

I, Norman L. Ochs, in a field survey on August 18, 19 99, do hereby certify that under requirements of P. A. 74, Michigan P.A. of 1970, the corner points mentioned in lines 1 and 2 above were in conformance with regulations and rules therefore as required in the current manual of survey instructions of the United States Department of the Interior, Bureau of Land Management or by a decree of a Court of Law and/or that the corner points mentioned in lines 3, 4 and 5 above were in conformance with the rules of the Michigan Board of Land Surveyors or by a Decree of a Court of Law, established, re-established, monumented, re-monumented, recovered, found as expressed below:

Note: Not more than 4 corners, all in the same town and range, may be recorded on this certificate.

South One Quarter Corner, Section 32, Ensley Township, Newaygo County, Michigan.

A. DESCRIPTION OF ORIGINAL MONUMENT AND ACCESSORIES AND/OR SUBSEQUENT RESTORATION:

G.L.O. N. Brookfield 1836 9" Beech N45°W 25 Links (16.5') #1 14" Beech N63°E 33 Links (21.78') #2	Newaygo County Road Commission Sheet 1 1/2" Pipe 12" Black Oak N45°E 55.8' #3 12" White Oak N55°E 73.5' #4 Maple Southeast 31.0' #5
Delos G. Anderson (County Surveyor) January 18 and 19, 1897 Book A, Page 193 Measured 40.05 Chains (2643.3') from the Southwest Corner to the South One Quarter Corner and measured 40.05 Chains (2643.3') from the South One Quarter Corner to the Southeast Corner of Section 32.	Newaygo County Road Commission Sheet 2" Iron 1935 14" Oak Northeast 55.7' #3 12" Oak Northeast 73.4' #4 12" Oak Southeast 58.7' #6 8" Maple Southeast 30.5' #5 10" Poplar North-Northwest 47.6' #7

OVER ↘

B. DESCRIPTION OF CORNER EVIDENCE FOUND AND/OR METHOD APPLIED IN RESTORING OR REESTABLISHING CORNER:

Found nothing. Set corner by prorating to 1985 distances. On line ± with the Southeast Corner and the Southwest Corner of Section 32 (1985 position was 0.032' North of the a straight line). The centerline of the East and West bituminous road is 6 feet ± South and the centerline of the North and South tower line is 74 feet ± West. There is no apparent occupation to the North. The condition of the recorded witnesses are: #1 thru #7 gone, #8 good condition, #9 and #10 gone, #11 good condition, #12 and #13 gone.

C. DESCRIPTION OF MONUMENT FOR CORNER AND ACCESSORIES ESTABLISHED TO PERPETUATE LOCATING THE POSITION OF THE CORNER:


Set a 2 3/4" diameter Harrison cast iron monument 20" long marked "County Survey" in a 8" diameter monument box as a substantial marker for the quarter corner and is accepted as a careful and faithful reestablishment of the original corner.

Power Pole S15°W 44.35' Found spike in Northwest side of pole. #8
 Northeast Corner, Section 6, T10N R11W, Kent County Remonumentation Monument, East 43.34' #11
 12" Beech N64°E 87.53' Set spike and tag #22439 in South side of tree.
 Power Pole S53°E 128.85' Set spike and tag #22439 in Southwest side of pole.
 Power Pole S76°W 344.74' Set spike and tag #22439 in Southeast side of pole.

Signed by Norman L. Ochs Date August 16, 1999
 Norman L. Ochs

Surveyor's Michigan License No. 22439 Form approved by Michigan State Board of Land Surveyors, Jan 28, 1975

Approved by Peer Review Group on August 19, 1999
 Norman L. Ochs, County Representative.

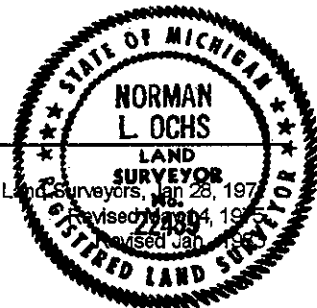

N.L.O.

SURVEY &
REMONUMENTATION

A. Description (cont.)

MAR 13 2000

SECTION

Patrick A. Salisbury R.L.S. #13594
December 24, 1973 Drawing Number 73197B
Found nothing. Set a 3/4" x 6" Cold Chisel
Power Pole S29°W 44.18' #8
6'-10" Twin Maple N75°E 68.13' #9
4" Maple N49°E 45.19' #10
Northeast Corner, Section 6, Solon Township, East 43.48' #11

Glen S. Hackbardt R.L.S. #25844
April 27, 1981 Recorded in Series L, Number 7850
Found 1/2" Iron
18" Pine S40°W 65.55' #12
Consumers Power Pole S15°W 44.0' #8
5" Maple N35°E 45.15' #10
14" Double Beech N50°E 65.36' #13

Norman L. Ochs R.L.S. #22439
LCRC #689 September 26, 1985
Found 1/2" Pipe. Removed and set a 4" x 20" Harrison cast iron monument marked "County Surveyor"
5" Maple S35°E 45.25' #10
12" Twin Beech N50°E 65.22' #13
Power Pole S15°W 44.38' #8
18" Pine Stump S40°W 65.65' #12
Northeast Corner, Section 6, Solon Township, East 43.06' #11
In the centerline of the East and West gravel road