

**SURVEY &
REMONUMENTATION**

APR 24 1995
1994 NEWAYGO COUNTY REMONUMENTATION PROJECT
COMMISSION

LAND CORNER RECORDATION CERTIFICATE
Filing Requirement of Act 74, Mich. P.A. 1970

VOL 001 PAGE 74


For corners in
Newaygo
(County)

	Located In:	Corner Code #
1. Public Land Survey	T <u>11N</u> R <u>11W</u>	<u>E-9</u>
	T _____ R _____	_____
	T _____ R _____	_____
	T _____ R _____	_____
2. Property Controlling in Section	S _____ T _____ R _____	_____
	S _____ T _____ R _____	_____
3. Miscellaneous Property in Sec.	S _____ T _____ R _____	_____
	S _____ T _____ R _____	_____
4. Lot No. _____, Recorded Plat _____		
5. Private Claims _____		

NEWAYGO COUNTY
REGISTER OF DEEDS
MARLENE TOOGOOD
'95 MAR 14 PM 3 51
Marlene Toogood
Register of Deeds Stamp & File Number

Norman L. Ochs October 12, 1994

I, Norman L. Ochs, in a field survey on _____ 19____ do hereby certify that under requirements of P.A. 74, Michigan P.A. of 1970, the corner points mentioned in lines 1 and 2 above were in conformance with regulations and rules therefore as required in the current manual of survey instructions of the United States Department of the Interior, Bureau of Land Management or by a decree of a Court of Law and/or that the corner points mentioned in lines 3, 4 and 5 above were in conformance with the rules of the Michigan Board of Land Surveyors or by a Decree of a Court of Law; established, re-established, monumented, re-monumented, recovered, found as expressed below:

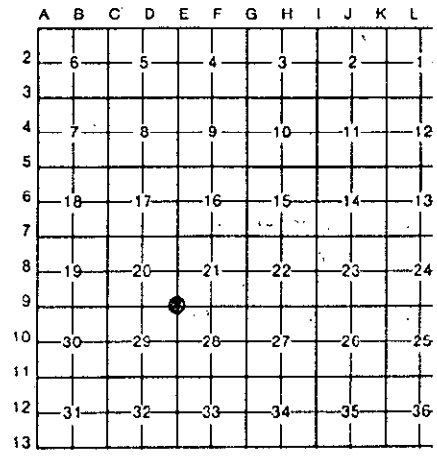

NOTE: Not more than 4 corners, all in the same town and range, may be recorded on this certificate.

S.W. Corner, Section 21, Ensley Twp., Newaygo County, MI

A. Description of original monument and accessories and/or subsequent restoration:
G.L.O. James H. Mullett 1837 Book # Unknown Page 139
12" Beech N30°E 8 lks. (5.28') #1 W. Oak S33°W 46 lks. (30.36') #6
10" Beech S38°W 30 lks. (19.80') #2

OVER----->

W.S. Merrill (Co. Surveyor) Sept. 29, 1887
Field Book 28 Page 145 Book A Pages 97 and 98
24" P. Stp. N50°E 3 1/4 lks. (2.15') #3 6" W. Oak S55°E 66 lks. (43.56')
1882 - 24" P. Stp. N53°W 31 1/2 lks. (20.79') #4 1887 - 24" P. Stp. N50°W 53 1.2 lks. (35.31') #5

B. Description of corner evidence found and/or method applied in restoring or reestablishing corner:
Found 1/2" x 18" rebar and broken glass and measured 2641.32 feet from the W. 1/4 Cor. to the S.W. Cor. of Sec. 21 and measured 2629.81 feet from the S.E. Cor. to the S. 1/4 Cor. of Sec. 20 and the condition of the recorded witnesses are: #1 thru #7 Gone, #8 and #9 Good Condition. #10 Good Condition, #11 thru #13 Gone.

C. Description of monument for corner and accessories established to perpetuate locating the position of the corner:
Removed 1/2' rebar and set a 4" dia. Harrison cast Iron Monument 20" long marked "County Surveyor" as a substantial marker for the section corner and is accepted as a careful and faithful reestablishment of the original corner.
1/2' Iron and Cap (#30389) N48°E 123.24' #10
8" Oak N70°E 69.90' Pound spike in side of tree (S.E.)
3/4" pipe N48°E 47.27'
38" Oak Stump N75°E 112.44' #9 Spike in S.E. side of tree
M.B.T. Box S70°E 57.72' (N.W. Corner)
24" Oak Stump S82°W 102.32' set spike in stump #8 (Easterly)



Signed by Norman L. Ochs Date November 22, 1994
Surveyor's Michigan License No. #22439

Approved by Peer Review Group on November 22, 1994
Norman L. Ochs, County Representative. *11/20*

A. Description.

Delos G. Anderson (Co. Surveyor) Book A page 184 May 3, 1897
Old Government Corner stone, stake on East side of North and South Road 3 feet.
Measured 40.25 ch. (2656.50 feet) from the N.W. Cor. to the N. 1/4 Cor. of Sec. 28 and measured 80.41 ch. (5307.06 feet) from the N.W. Cor. to the S.W. Cor. of Sec. 28.

William M. Jacques (Co. Surveyor)
Book 1 pages 10 and 11
May 15, 1903
Corner was gone, I established corner by proportional measurement North, South, East and West. Set stake by iron set by W.S. Merrill stake and put glass around stake.
Measured 40.07 ch. (2644.62 feet) from the S.E. Cor. to the E. 1/4 Cor. of Sec. 20 and measured 39.93 ch. (2635.38 feet) from the S.E. Cor. to the S. 1/4 Cor. of Sec. 20.

Book 9 Page 22 May 15, 1903 Pine stake with broken glass around stake
Measured 80 ch. 21 3/4 feet (5301.75 feet) from the E. 1/4 Cor. of Sec. 20 to the E. 1/4 Cor. of Sec. 29 and measured 120 ch. 10/12 feet (7920.85 feet) from the S. 1/4 Cor. of Sec. 21 to the S.W. Cor. of Sec. 20

Lyle S. Shepherd R.L.S. #503 Book 73 Pages 26 and 27
Gas Pipe Found
U.S.G.S. B.M. S40°+W 56.5' #6
Oak S45°+W 45.5' #7
Measured 2632 feet from the S.E. Cor. to the S. 1/4 Cor. of Sec. 20.

M.C.R.C. Sheet
1 1/2" Pipe
12" W. Oak S80°W 101.70' #8
24" W. Oak S31°W 46.0' #7
30" W. Oak N72°W 111.1' #9
U.S.G.S. B.M. S40°W 56.5' #6
Measured 5303.20 feet from the N.E. Cor. to the S.E. Cor. of Sec. 29.

Newaygo Engineering and Survey Co. July 18, 1978
Found 1/2" Rod Job #88010b and #78122AC
36" W. Oak S42°W 46.98' #7
24" W. Oak S82°W 102.32' #8
38" W. Oak Stump N75°E 112.44' #9
U.S.G.S. B.M. S35°W 56.46' #6

William Fries Jr. R.L.S. #30389
January 5, 1992
Following Road Construction set 1/2" iron and cap 3 feet East of centerline of North and South road
Nail and tag in Ground AZ55° 123.01' #10
Nail and tag in ground AZ55° 177.58' #11
Nail and tag in ground AZ278° 91.55' #12
Nail and tag in ground AZ278° 182.19' #13

William Fries Jr. R.L.S. #30389 April 8, 1992
U.S.G.S. Mon. AZ 220° 56.36' #6
Nail and tag in ground AZ55° 123.01' #10
Nail and tag in ground AZ55° 177.58' #11
Nail and tag in ground AZ278° 91.55' #12
Nail and tag in ground AZ278° 182.19' #13

William Fries Jr. R.L.S. #30389 January 5, 1993
Nail and Tag AZ55° 123.01' #10
Nail and Tag AZ55° 177.58' #11
Nail and Tag AZ278° 91.55' #12
Nail and Tag AZ278° 182.19' #13