

**SURVEY & REMONUMENTATION**

MAR 13 2000

1999 Newaygo County Remonumentation Project **NEWAYGO COUNTY REGISTER OF DEEDS**  
**LAND CORNER RECORDATION CERTIFICATE** LINDA M. BROWN  
 FILING REQUIREMENT of Act 74, Mich. P.A. 1970

'00 FEB 28 PM 1 09

*Linda M. Brown*

VOL. 2 286

Register of Deeds Stamp & File Number

**SECTION**  
 For corners in  
Newaygo  
 (County)

Located in:	Corner Code #
1. Public Land Survey	T <u>11N</u> R <u>11W</u>
	T ___ R ___
	T ___ R ___
	T ___ R ___
2. Property Controlling in Section	S ___ T ___ R ___
	S ___ T ___ R ___
3. Miscellaneous Property in Sec.	S ___ T ___ R ___
	S ___ T ___ R ___
4. Lot No. _____, Recorded Plat _____	
5. Private Claims _____	

I, Norman L. Ochs, in a field survey on February 11, 1999, do hereby certify that under requirements of P. A. 74, Michigan P.A. of 1970, the corner points mentioned in lines 1 and 2 above were in conformance with regulations and rules therefore as required in the current manual of survey instructions of the United States Department of the Interior, Bureau of Land Management or by a decree of a Court of Law and/or that the corner points mentioned in lines 3, 4 and 5 above were in conformance with the rules of the Michigan Board of Land Surveyors or by a Decree of a Court of Law; established, re-established, monumented, re-monumented, recovered, found as expressed below:

**Note: Not more than 4 corners, all in the same town and range, may be recorded on this certificate.**

West One Quarter Corner, Section 11, Ensley Township, Newaygo County, Michigan.

	A	B	C	D	E	F	G	H	I	J	K	L	M
1													
2	6	5	4	3	2	1							
3													
4	7	8	9	10	11	12							
5													
6	18	17	16	15	14	13							
7													
8	19	20	21	22	23	24							
9													
10	30	29	28	27	26	25							
11													
12	31	32	33	34	35	36							
13													

**A. DESCRIPTION OF ORIGINAL MONUMENT AND ACCESSORIES AND/OR SUBSEQUENT RESTORATION:**

G.L.O. James H. Mullett 1837 6" Black Oak N22°E 10 Links (6.60')#1 8" Black Oak N83°W 20 Links (13.20')#2	Glen S. Hackbardt R.L.S. #25844 1980 Set 1/2" Rod on fence line extended from the East and West at a point midway between the two North and South fences. 14" Oak N45°E 37.48' #3 8" Oak S85°E 31.00' #4 18" Oak S40°E 55.10' #5
Winfield S. Merrill (County Surveyor) November 15, 1887 Book A, Pages 101 and 102 Original bearing trees of Government survey.	Norman L. Ochs R.L.S. #22439 Drawing Number 83200AC November 23, 1983 Found 1/2" Rod in cut area. Centerline of trail road is 3 feet East. 14" Red Oak N45°E 37.48' #3 8" White Oak S85°E 31.00' #4 18" Red Oak S40°E 55.10' #5
Glen S. Hackbardt R.L.S. #25844 February 6, 1995 Recorded in Liber 362, Page 8155 Found 1/2" Rebar 12" Oak S40°W 54.10' #6 8" Pine N85°W 66.38' #7 8" Oak S85°E 31.0' #4	

**B. DESCRIPTION OF CORNER EVIDENCE FOUND AND/OR METHOD APPLIED IN RESTORING OR REESTABLISHING CORNER:**


Found 1/2" Rerod with cap #25844 (was removed later by road construction) on line ± with the centerline of the North and South gravel road, on line ± with the stump row fence going East and the fence going West is 2 feet ± South. The condition of the recorded witnesses are: #1 thru #4 gone, #5 thru #7 good condition.

**C. DESCRIPTION OF MONUMENT FOR CORNER AND ACCESSORIES ESTABLISHED TO PERPETUATE LOCATING THE POSITION OF THE CORNER:**

I replaced (in the exact location of the 1/2" Rerod) with a 4" diameter Harrison cast iron monument 30" long marked "County Surveyor" as a substantial marker for the quarter corner and is accepted as a careful and faithful reestablishment of the original corner.

26" Black Oak (blazed) S41°E 55.19' Set spike with tag #22439 in Northeasterly side of tree. #5  
 12" Black Oak (blazed) S50°W 54.18' Found spike with tag #22439 in Easterly side of tree. #6  
 12" Red Pine (blazed) N80°W 66.68' Found spike with tag #22439 in South side of tree. #7  
 10" White Oak (blazed) S83°E 33.04' Found spike with tag #22439 in North side of tree.

Signed by Norman L. Ochs Date August 16, 1999  
 Norman L. Ochs

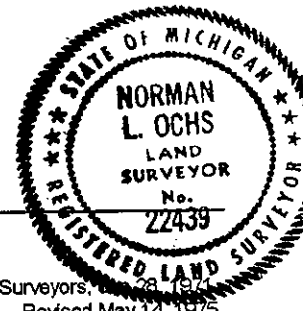

Surveyor's Michigan License No. 22439 Form approved by Michigan State Board of Land Surveyors, 1974  
 Approved by Peer Review Group on August 19, 1999 Revised May 14, 1975  
 Norman L. Ochs, County Representative. Revised Jan., 1983

*N.L.O.*