

MAR 1 8 2000

1999 Newaygo County Remonumentation Project

NEWAYGO COUNTY REGISTER OF DEEDS LINDA H. BROWN

SECTION LAND CORNER RECORDATION CERTIFICATE FILING REQUIREMENT of Act 74, Mich. P.A. 1970

FEB 28 PM 1 09

For corners in Newaygo (County) Located in: Corner Code # 1. Public Land Survey T 11N R 11W L-13 2. Property Controlling in Section S T R 3. Miscellaneous Property in Sec. S T R 4. Lot No. Recorded Plat 5. Private Claims

Linda M. Brown

VOL. 2 290

Register of Deeds Stamp & File Number

Grid table with columns A-L and rows 1-13. Cell (13, L) contains a black circle.

I, Norman L. Ochs, in a field survey on February 11, 1999, do hereby certify that under requirements of P. A. 74, Michigan P.A. of 1970, the corner points mentioned in lines 1 and 2 above were in conformance with regulations and rules therefore as required in the current manual of survey instructions of the United States Department of the Interior, Bureau of Land Management or by a decree of a Court of Law and/or that the corner points mentioned in lines 3, 4 and 5 above were in conformance with the rules of the Michigan Board of Land Surveyors or by a Decree of a Court of Law; established, re-established, monumented, re-monumented, recovered, found as expressed below:

Note: Not more than 4 corners, all in the same town and range, may be recorded on this certificate.

South One Quarter Corner, Section 36, Ensley Township, Newaygo County, Michigan.

A. DESCRIPTION OF ORIGINAL MONUMENT AND ACCESSORIES AND/OR SUBSEQUENT RESTORATION:

G.L.O. N. Brookfield 1836 18" Pine N46°W 43 Links (28.38')#1 10" Maple N38°E 11 Links (7.26')#2

Norman L. Ochs R.L.S. #22439 LCRC #696 September 27, 1985 Drawing Number 85001 and 85002 No evidence found. Set corner 3' South of the East and West road and on fence line North which is half way and on line between the Southwest and Southeast Corners of Section 36. Set a 4" x 30" Harrison cast iron monument marked "County Surveyor" at P.K. nail. Measured 289.00 feet from the Northeast Corner of Section 2, T10N R12W, to the South One Quarter Corner of Section 36, T11N R11W. Point on big rock North 32.84' #4 12" Forked Elm N20°E 49.62' #5 6" Elm N30°E 60.76' #6 8" Elm S45°E 34.90' #7

Delos G. Anderson (County Surveyor) Book A Pages 249 and 250 May 1 thru 4, 1899 36" Pine N80°W 50 Links (33')#3 Corner shows to be half way and on line between the Southwest and Southeast Corners.

B. DESCRIPTION OF CORNER EVIDENCE FOUND AND/OR METHOD APPLIED IN RESTORING OR REESTABLISHING CORNER:

Found 4" Harrison cast iron monument marked "County Surveyor" on line ± with woods line going North. The centerline of the East and West bituminous road is 3 feet North. The condition of the recorded witnesses are: #1 thru #3 gone, #4 good condition, #5 gone, #6 found (6" Elm stump N30°E 61' ± to center), #7 gone.

C. DESCRIPTION OF MONUMENT FOR CORNER AND ACCESSORIES ESTABLISHED TO PERPETUATE LOCATING THE POSITION OF THE CORNER:


Accepted 4" Harrison cast iron monument marked "County Surveyor" as a substantial marker for the quarter corner and is accepted as a careful and faithful reestablishment of the original corner.

Point on big rock N06°E 32.92' #4 Power Pole S05°E 146.70' Set spike with tag #22439 in West side of pole. Power Pole S54°W 236.23' Set spike with tag #22439 in Northwestern side of pole. Northeast Corner, Section 2, Solon Township, 4" diameter Harrison cast iron monument with Kent County brass cap East 211.45'

Signed by Norman L. Ochs Date August 16, 1999 Surveyor's Michigan License No. 22439

Form approved by Michigan State Board of Land Surveyors, Jan 28, 1971 Revised May 14, 1975 Revised Jan., 1983

Approved by Peer Review Group on August 19, 1999 Norman L. Ochs, County Representative.

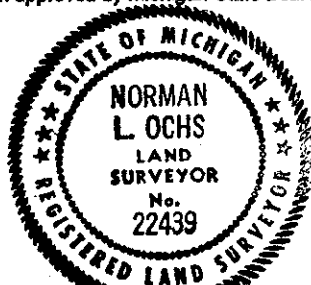

N.L.O.