

SURVEY & REMONUMENTATION

MAR 19 1998

1997 Newaygo County Remonumentation Project

NEWAYGO COUNTY REGISTER OF DEEDS
LINDA M. BROWN

**LAND CORNER RECORDATION CERTIFICATE
FILING REQUIREMENT of Act 74, Mich. P.A. 1970**

'98 MAR 6 PM 12 34

SECTION

For corners in

Newaygo
(County)

Located in:

Corner Code #

Linda M. Brown

1. Public Land Survey

T 11N R 11W
T 12N R 11W

M-1 ✓
M-13

VOL. 2

70

2. Property Controlling in Section

S ___ T ___ R ___

3. Miscellaneous Property in Sec.

S ___ T ___ R ___

4. Lot No. _____, Recorded Plat _____

5. Private Claims _____

Register of Deeds Stamp & File Number

	A	B	C	D	E	F	G	H	I	J	K	L	M
1													
2	6		5		4		3		2		1		
3													
4	7		8		9		10		11		12		
5													
6	18		17		16		15		14		13		
7													
8	19		20		21		22		23		24		
9													
10	30		29		28		27		26		25		
11													
12	31		32		33		34		35		36		
13													

I, Norman L. Ochs, in a field survey on February 17, 1997, do hereby certify that under requirements of P. A. 74, Michigan P.A. of 1970, the corner points mentioned in lines 1 and 2 above were in conformance with regulations and rules therefore as required in the current manual of survey instructions of the United States Department of the Interior, Bureau of Land Management or by a decree of a Court of Law and/or that the corner points mentioned in lines 3, 4 and 5 above were in conformance with the rules of the Michigan Board of Land Surveyors or by a Decree of a Court of Law; established, re-established, monumented, re-monumented, recovered, found as expressed below:

Note: Not more than 4 corners, all in the same town and range, may be recorded on this certificate.

Note: This Corner is common to both sections.

Northeast Corner, Section 1, Ensley Township, Newaygo County, Michigan
Southeast Corner, Section 36, Croton Township, Newaygo County, Michigan

A. DESCRIPTION OF ORIGINAL MONUMENT AND ACCESSORIES AND/OR SUBSEQUENT RESTORATION:

G.L.O. Mullett and Brookfield 1838
16" White Oak S65°E 16 Links (10.56') #1
12" White Oak N76°W 40 Links (26.4') #2

Thaddeus L. Waters (Newaygo Deputy County Surveyor)
Book A Page 7 September 16-26, 1876
Plow Point on North side of Pine Root with earthenware on East side of post
White Oak Stump Northeast 6' #5

Newaygo County Surveyor's Witness Book Page 140
Undated
Oak Stump S43°E 58½' #3
16" White Oak S05¼°W 106' #4

F.A. Palmer (Montcalm County Surveyor)
Book 1 Page 283 May 1881
Found several pieces of the old corner stake. Set a gas pipe and horseshoe and broken pieces of glass.

OVER ↴


B. DESCRIPTION OF CORNER EVIDENCE FOUND AND/OR METHOD APPLIED IN RESTORING OR REESTABLISHING CORNER:

Found Montcalm County Harrison monument and the centerline of the North and South road is 8.2 feet East and the centerline of road going East is 4 feet North and the South edge of woods going West is 7.5 feet North. The condition of the recorded witnesses are: #1 thru #8 gone, #9 broken, #10 good condition, #11 gone, #12 thru #14 good condition.

C. DESCRIPTION OF MONUMENT FOR CORNER AND ACCESSORIES ESTABLISHED TO PERPETUATE LOCATING THE POSITION OF THE CORNER:

Accepted Montcalm County Harrison monument as a substantial marker for the section corner and is accepted as a careful and faithful reestablishment of the original corner.

14"-14"-10" Triple White Oak N55°W 43.20' Found spike in Northeast side of tree. #10
26" Maple S71°E 189.15' Set spike and tag in Northeast side of tree. #12
16" Cherry N78°W 66.68' Found spike in South side of tree. #13
Top Center of Phone Riser S35°E 65.20' #14
Power Pole N56°E 214.22' Set spike and tag in Northwest side of pole.
14" White Oak N20°W 83.18' Found square concrete nail in Northeast side of tree.

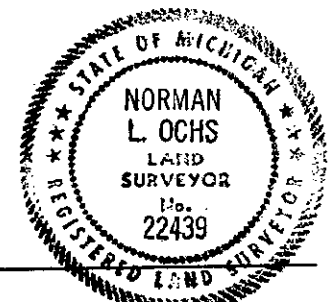

Signed by Norman L. Ochs Date September 8, 1997

Surveyor's Michigan License No. 22439 Form approved by Michigan State Board of Land Surveyors, Jan 28, 1971

Approved by Peer Review Group on October 14, 1997 Revised May 14, 1975
Norman L. Ochs, County Representative. Revised Jan., 1983

N. L. O.