

**SURVEY &  
REMONUMENTATION**

**MAR 19 1998**

**1997 Newaygo County Remonumentation Project**

**NEWAYGO COUNTY  
REGISTER OF DEEDS  
LINDA M. BROWN**

**SECTION**

**LAND CORNER RECORDATION CERTIFICATE  
FILING REQUIREMENT of Act 74, Mich. P.A. 1970**

**'98 MAR 6 PM 12 34**

For corners in  
Newaygo  
(County)

Located in: \_\_\_\_\_ Corner Code # \_\_\_\_\_

1. Public Land Survey T 11N R 11W M-2  
T \_\_\_\_\_ R \_\_\_\_\_  
T \_\_\_\_\_ R \_\_\_\_\_  
T \_\_\_\_\_ R \_\_\_\_\_

2. Property Controlling S \_\_\_\_\_ T \_\_\_\_\_ R \_\_\_\_\_  
in Section S \_\_\_\_\_ T \_\_\_\_\_ R \_\_\_\_\_

3. Miscellaneous S \_\_\_\_\_ T \_\_\_\_\_ R \_\_\_\_\_  
Property in Sec. S \_\_\_\_\_ T \_\_\_\_\_ R \_\_\_\_\_

*Linda M. Brown*

**VOL. 2**

**71**

4. Lot No. \_\_\_\_\_, Recorded Plat \_\_\_\_\_  
5. Private Claims \_\_\_\_\_

**Register of Deeds Stamp & File Number**

I, Norman L. Ochs, in a field survey on February 17, 1997, do hereby certify that under requirements of P. A. 74, Michigan P.A. of 1970, the corner points mentioned in lines 1 and 2 above were in conformance with regulations and rules therefore as required in the current manual of survey instructions of the United States Department of the Interior, Bureau of Land Management or by a decree of a Court of Law and/or that the corner points mentioned in lines 3, 4 and 5 above were in conformance with the rules of the Michigan Board of Land Surveyors or by a Decree of a Court of Law; established, re-established, monumented, re-monumented, recovered, found as expressed below:

	A	B	C	D	E	F	G	H	I	J	K	L	M
1													
2	6		5		4		3		2		1		
3													
4	7		8		9		10		11		12		
5													
6	18		17		16		15		14		13		
7													
8	19		20		21		22		23		24		
9													
10	30		29		28		27		26		25		
11													
12	31		32		33		34		35		36		
13													

**Note: Not more than 4 corners, all in the same town and range, may be recorded on this certificate.**

East One Quarter Corner, Section 1, Ensley Township, Newaygo County, Michigan

**A. DESCRIPTION OF ORIGINAL MONUMENT AND ACCESSORIES AND/OR SUBSEQUENT RESTORATION:**

G.L.O. J. Brookfield and John Hodgson 1838  
10" Black Oak S82°W 30 Links (19.8')#1  
8" Cherry N74°W 25 Links (16.5')#2

1859, No name, no date  
Field Book at Montcalm County Register of Deeds Page 19  
New bearing tree:  
13" White Oak S67½°E 49 Links (32.34')#6

John C. Brewster (County Surveyor)  
Book A Page 7 September 19-26, 1876  
Pine Root and Stone above.

F.A. Palmer (Montcalm County Surveyor)  
May 1881 Book 1 Pages 282 and 283 Montcalm County  
Found stake and broken glass, mortar and stones. Found roots of Oak and Mr. Haskins said he had seen the cherry standing very near where I wanted it. Set an Iron rod with a hook on top of it.

J.F. Daoust (Montcalm County Surveyor)  
Pages 336 and 337 May 1907  
Reestablished on straight line and at proportional distances from adjacent section corners. Drove gas pipe with cobbles.

**OVER**

**B. DESCRIPTION OF CORNER EVIDENCE FOUND AND/OR METHOD APPLIED IN RESTORING OR REESTABLISHING CORNER:**

Found Montcalm County Harrison monument in monument box in the centerline of a tree row going West and the centerline of the North and South road is 3 feet East and the centerline of road going East is 9 feet South. The condition of the recorded witnesses are: #1 and #2 gone, #3 stump, #4 and #5 good condition, #6 thru #10 gone, #11 and #12 good condition.

**C. DESCRIPTION OF MONUMENT FOR CORNER AND ACCESSORIES ESTABLISHED TO PERPETUATE LOCATING THE POSITION OF THE CORNER:**

Accepted Montcalm County Harrison monument in monument box as a substantial marker for the section corner and is accepted as a careful and faithful reestablishment of the original corner.


24" Oak Stump West 39.94' Found spike in South side of stump. #3  
Consumers Pole N27°W 131.99' Found spike in West side of pole. #4  
Consumers Pole S21°W 247.72' Found spike in West side of pole. #5  
Stop sign N82°E 40.77' Measured to West side of sign. #11  
Top center Phone Riser S35°E 59.08' #12  
Power Pole N77°E 262.23' Set spike and tag in North side of pole.

Signed by Norman L. Ochs Date September 8, 1997

Surveyor's Michigan License No. 22439

Form approved by Michigan State Board of Land Surveyors, Jan 28, 1971

Approved by Peer Review Group on October 14, 1997  
Norman L. Ochs, County Representative.

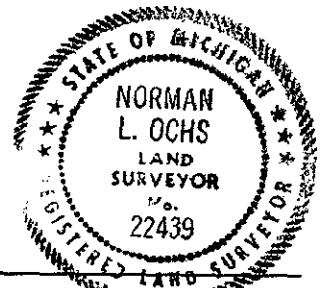

*N.L.O.*

Revised May 14, 1975  
Revised Jan., 1983

A. Description (cont.)

J. F. Daoust (Montcalm County Surveyor)

Pages 78 and 79 Field Books at Montcalm County Register of Deeds.

Reestablished on straight line and at proportional distances from adjacent section corners. Drove gas pipe and set stones around same.

16" Oak S15½°W 173½ Links (114.51') #7

16" Oak S75¼°E 185½ Links (122.43') #8

Montcalm County Road Commission

Files 11-10 April 1959

Iron Stake and Stone

Telephone Pole Southeast 65.60' #9

18" Stump West 38.45' #3

Glen S. Hackhardt R.L.S. #25844

1987 Found Bolt

14" Oak West 39.70' #3

Consumer Power N40°W 132.10' #4

Consumer Power S20° 247.90' #5

Montcalm County Remonumentation Program

July 29, 1994 Recorded in Liber 3 Page 126, Montcalm County Register of Deeds. Found 12" long square boat spike at road surface below spike, found gas pipe in nest of stone, 1.3 feet below surface, 2.5 feet West of centerline, North and South road and 7 feet North of centerline East. Set Remonumentation corner and monument box over gas pipe.

Power Pole N40°W 123.23' #4

18" Black Oak (dead) S82°W 40.07' #10

Stop Sign N80°E 41.1' #11

Telephone Riser Box Top Center S45°E 59.0' #12