

SURVEY & REMONUMENTATION

MAR 13 2000

1999 Newaygo County Remonumentation Project

NEWAYGO COUNTY REGISTER OF DEEDS
LINDA H. BROWN

SECTION

LAND CORNER RECORDATION CERTIFICATE
FILING REQUIREMENT of Act 74, Mich. P.A. 1970

00 FEB 28 PM 1 09

For corners in Newaygo (County) Located in: T 11N R 12W Corner Code # E-13

1. Public Land Survey
T 11N R 12W
T R
T R
T R

2. Property Controlling in Section
S T R
S T R

3. Miscellaneous Property in Sec.
S T R
S T R

4. Lot No. _____, Recorded Plat _____

5. Private Claims _____

Linda M. Brown

VOL. 2

295

Register of Deeds Stamp & File Number

	A	B	C	D	E	F	G	H	I	J	K	L	M
1													
2	6		5		4		3		2		1		
3													
4	7		8		9		10		11		12		
5													
6	18		17		16		15		14		13		
7													
8	19		20		21		22		23		24		
9													
10	30		29		28		27		26		25		
11													
12	31		32		33		34		35		36		
13													

I, Norman L. Ochs, in a field survey on February 19, 1999, do hereby certify that under requirements of P. A. 74, Michigan P.A. of 1970, the corner points mentioned in lines 1 and 2 above were in conformance with regulations and rules therefore as required in the current manual of survey instructions of the United States Department of the Interior, Bureau of Land Management or by a decree of a Court of Law and/or that the corner points mentioned in lines 3, 4 and 5 above were in conformance with the rules of the Michigan Board of Land Surveyors or by a Decree of a Court of Law; established, re-established, monumented, re-monumented, recovered, found as expressed below.

Note: Not more than 4 corners, all in the same town and range, may be recorded on this certificate.

Southeast Corner, Section 32, Grant Township, Newaygo County, Michigan.

A. DESCRIPTION OF ORIGINAL MONUMENT AND ACCESSORIES AND/OR SUBSEQUENT RESTORATION:

G.L.O. N. Brookfield 1836
10" Sugar N16°E 32 Links (21.12') #1
10" Beech N17°W 13 Links (8.58') #2

Norman L. Ochs R.L.S. #22439
June 10, 1978 Found "T" Iron
18" Hickory N36°W 34.40' #3
3" Basswood North 38.50' #7
14" Maple N85°E 187.55' #8

Francis E. Spicer R.L.S. #7877
LCRC #295 August 22, 1973
Found 1/2" Iron
Centerline road East and West, East line woods North
14" Hickory N40°W 34.37' #3
Michigan Bell Telephone Pole S50°W 49.02' #4
Consumers Power Pole North 64.55' #5
Southwest Corner Porch Foundation N60°E 190.60' #6

OVER ↙

B. DESCRIPTION OF CORNER EVIDENCE FOUND AND/OR METHOD APPLIED IN RESTORING OR REESTABLISHING CORNER:

Found 4" x 30" Harrison cast iron monument marked "County Surveyor" broken, 2.5 feet below grade. The centerline of the East and West bituminous road is 2 feet South. The condition of the recorded witnesses are: #1 thru #4 gone, #5 thru #10 good condition.

C. DESCRIPTION OF MONUMENT FOR CORNER AND ACCESSORIES ESTABLISHED TO PERPETUATE LOCATING THE POSITION OF THE CORNER:

Replaced broken Harrison with a 4" diameter Harrison cast iron monument 20" long marked "County Surveyor" as a substantial marker for the section corner and is accepted as a careful and faithful reestablishment of the original corner.

Power Pole North 64.70' #5
Southwest Corner Porch Foundation N59°E 190.72' #6
12" - 18" Twin Basswood N03°E 37.43' Set spike with tag #22439 in East side of tree. #7
24" Maple N82°E 187.08' Set spike with tag #22439 in South side of tree. #8
44" Maple N30°E 50.51' Set spike with tag #22439 in East side of tree. #9
North One Quarter, Section 5, T10N R12W, 4" diameter Harrison cast iron monument with Kent County brass cap, West 305.43' #10

Signed by Norman L. Ochs

Date August 16, 1999

Surveyor's Michigan License No. 22439


Form approved by Michigan State Board of Land Surveyors, Jan 28, 1971

Revised May 14, 1975

Revised Jan., 1983

Approved by Peer Review Group on August 19, 1999
Norman L. Ochs, County Representative.

N.L.O.

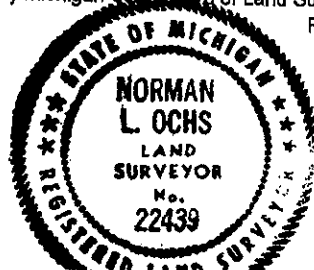

A. Description (cont.)

Norman L. Ochs R.L.S. #22439

LCRC #679 June 25, 1985

Found "T" iron on top of a 1¼" Well Point. Removed and set a 4" x 30" Harrison cast iron monument marked "County Surveyor"

18" Hickory N40°W 34.52' #3

3" Basswood North 38.50' #7

14" Maple N85°E 187.55' #8

Southwest Corner Porch Foundation N60°E 190.68' #6

36" Maple N35°W 50.07' #9

North One Quarter Corner, Section 5, T10N R12W, West 305.43' #10

Charles E. Fricke R.L.S. #21781

Recorded in Liber 354, Page 3800 and 3801 July 6, 1992

Found Harrison monument

18" Hickory N40°W 34.52' #3

3" Basswood North 38.50' #7

14" Maple N85°E 187.55' #8

36" Maple N35°W 50.07' #9

SURVEY &
REMONUMENTATION

MAR 1 8 2000

SECTION