

SURVEY & REMONUMENTATION

MAR 13 2000

SECTION

NEWAYGO COUNTY REGISTER OF DEEDS

DA M. BROWN

1999 Newaygo County Remonumentation Project

LAND CORNER RECORDATION CERTIFICATE FEB 28 PM 1 09
FILING REQUIREMENT of Act 74, Mich. P.A. 1970

Linda M. Brown

For corners in <u>Newaygo</u> (County)	Located in:	Corner Code #
1. Public Land Survey	T <u>11N</u> R <u>12W</u>	<u>H-13</u>
	T ___ R ___	_____
	T ___ R ___	_____
	T ___ R ___	_____
2. Property Controlling in Section	S ___ T ___ R ___	_____
	S ___ T ___ R ___	_____
3. Miscellaneous Property in Sec.	S ___ T ___ R ___	_____
	S ___ T ___ R ___	_____
4. Lot No. _____, Recorded Plat _____		
5. Private Claims _____		

VOL. 2

299

Register of Deeds Stamp & File Number

	A	B	C	D	E	F	G	H	I	J	K	L	M
1													
2	6	5	4	3	2	1							
3													
4	7	8	9	10	11	12							
5													
6	18	17	16	15	14	13							
7													
8	19	20	21	22	23	24							
9													
10	30	29	28	27	26	25							
11													
12	31	32	33	34	35	36							
13													

I, Norman L. Ochs, in a field survey on February 17, 1999, do hereby certify that under requirements of P. A. 74, Michigan P.A. of 1970, the corner points mentioned in lines 1 and 2 above were in conformance with regulations and rules therefore as required in the current manual of survey instructions of the United States Department of the Interior, Bureau of Land Management or by a decree of a Court of Law and/or that the corner points mentioned in lines 3, 4 and 5 above were in conformance with the rules of the Michigan Board of Land Surveyors or by a Decree of a Court of Law, established, re-established, monumented, re-monumented, recovered, found as expressed below:

Note: Not more than 4 corners, all in the same town and range, may be recorded on this certificate.

South One Quarter Corner, Section 34, Grant Township, Newaygo County, Michigan.

A. DESCRIPTION OF ORIGINAL MONUMENT AND ACCESSORIES AND/OR SUBSEQUENT RESTORATION:

G.L.O. N. Brookfield 1836
14" Black Ash Corner
Measured 520 Links (343.2') from the South One Quarter Corner of Section 34, T11N R12W to the Northwest Corner of Section 3, T10N R12W

Newaygo County Road Commission Sheet
1 1/2" Iron
South leg of tower N02°E 301.0' #1
Northwest Corner House N60°E 204.2' #2
Power Pole N70°W 107.65' #3

William M. Jacques (County Surveyor)
Book 8, Pages 33 and 34 August 19 and 20, 1913
Stake and glass
Measured 40 Chains 48 feet (2688') from the South One Quarter Corner to the Southwest Corner of Section 34, T11N R12W.

Norman L. Ochs R.L.S. #22439
February 23, 1983 Drawing Number 83020B
Found 1 1/2" Iron
Northwest Corner House N60°E 204.35' #2
South leg of tower at ground N02°E 301.0' #1
Power Pole N70°W 110.68' #4
Centerline of the East and West road North 3' #5

OVER ↵

B. DESCRIPTION OF CORNER EVIDENCE FOUND AND/OR METHOD APPLIED IN RESTORING OR REESTABLISHING CORNER:

Found 4" Harrison cast iron monument marked "County Surveyor". The centerline of the East and West bituminous road is 3 feet ± North. The condition of the recorded witnesses are: #1 good condition, #2 and #3 gone, #4 and #5 good condition, #6 gone, #7 good condition.

C. DESCRIPTION OF MONUMENT FOR CORNER AND ACCESSORIES ESTABLISHED TO PERPETUATE LOCATING THE POSITION OF THE CORNER:

Accepted 4" Harrison cast iron monument marked "County Surveyor" as a substantial marker for the quarter corner and is accepted as a careful and faithful reestablishment of the position of the original corner.


South leg of tower N02°E 301.10' #1
Power Pole N70°W 109.26' Set spike with tag #22439 in Northeasterly side of tree. #4
Centerline of East and West road North 3' #5
Northwest Corner, Section 4, T10N R12W, (4" diameter Harrison cast iron monument with Kent County brass cap)
West 343.25' #7
24" Willow N42°E 138.70' Set spike with tag #22439 in Northwesterly side of tree.

Signed by Norman L. Ochs Date August 16, 1999
Norman L. Ochs
Surveyor's Michigan License No. 22439

Form approved by Michigan State Board of Land Surveyors

Approved by Peer Review Group on December 16, 1999
Norman L. Ochs, County Representative.

N.L.O.

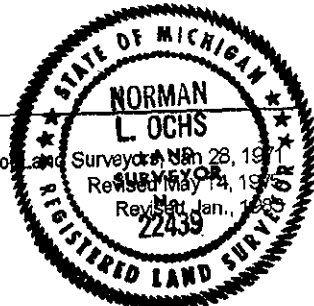

A. Description (cont.)

Norman L. Ochs R.L.S. #22439

LCRC #682 September 17, 1985

Found 1½" Iron rod. Removed and set a 4" x 20" Harrison cast iron monument marked "County Surveyor".

South leg of tower N02°E 301.0' at ground level #1

Power Pole N70°W 110.68' #4

30" Poplar N55°E 178.00' #6

Northwest Corner, Section 4, T10N R12W, West 343.14' #7

**SURVEY &
REMONUMENTATION**

MAR 13 2000

SECTION