

**SURVEY & REMONUMENTATION**

**MAR 18 2000**

**SECTION**

**1999 Newaygo County Remonumentation Project**

**LAND CORNER RECORDATION CERTIFICATE  
FILING REQUIREMENT of Act 74, Mich. P.A. 1970**

**NEWAYGO COUNTY  
REGISTER OF DEEDS  
LINDA M. BROWN**

**00 FEB 28 PM 1 10**

*Linda M. Brown*

**VOL. 2**

**301**

**Register of Deeds Stamp & File Number**

	A	B	C	D	E	F	G	H	I	J	K	L	M
1													
2	6	5	4	3	2	1							
3													
4	7	8	9	10	11	12							
5													
6	18	17	16	15	14	13							
7													
8	19	20	21	22	23	24							
9													
10	30	29	28	27	26	25							
11													
12	31	32	33	34	35	36							
13													

For corners in  
Newaygo  
(County)

Located in: T 11N R 12W

Corner Code # L-13

1. Public Land Survey  
T      R       
T      R       
T      R       
T      R     

2. Property Controlling  
in Section  
S      T      R       
S      T      R     

3. Miscellaneous  
Property in Sec.  
S      T      R       
S      T      R     

4. Lot No.           , Recorded Plat           

5. Private Claims           

I, Norman L. Ochs, in a field survey on February 17, 19 99, do hereby certify that under requirements of P. A. 74, Michigan P.A. of 1970, the corner points mentioned in lines 1 and 2 above were in conformance with regulations and rules therefore as required in the current manual of survey instructions of the United States Department of the Interior, Bureau of Land Management or by a decree of a Court of Law and/or that the corner points mentioned in lines 3, 4 and 5 above were in conformance with the rules of the Michigan Board of Land Surveyors or by a Decree of a Court of Law; established, re-established, monumented, re-monumented, recovered, found as expressed below:

**Note: Not more than 4 corners, all in the same town and range, may be recorded on this certificate.**

Southeast Corner, Section 34, Grant Township, Newaygo County, Michigan.

**A. DESCRIPTION OF ORIGINAL MONUMENT AND ACCESSORIES AND/OR SUBSEQUENT RESTORATION:**

G.L.O. N. Brookfield 1836  
10" Hemlock N18°E 18 Links (11.88') #1  
10" Hemlock N62°W 21 Links (13.86') #2

Lyle S. Shepherd R.L.S. #503  
Witness Book Number 2, Page 156  
Telephone Pole S14°E 34.4' #3  
Power Pole N59°W 77.1' #4  
Northwest Corner House S46°E 139.53' #5

William M. Jacques (County Surveyor)  
Book 8, Page 50 thru 52 October 10, 1904  
Measured 78 Chains 60 feet (5208') from the Southwest Corner to the Southeast Corner of Section 35.

**OVER**

**B. DESCRIPTION OF CORNER EVIDENCE FOUND AND/OR METHOD APPLIED IN RESTORING OR REESTABLISHING CORNER:**

Found 4" Harrison cast iron monument marked "County Surveyor" in the centerline of the East and West bituminous road and in the centerline of bituminous road going North. The condition of the recorded witnesses are: #1 thru #4 gone, #5 thru #10 good condition, #11 gone.

**C. DESCRIPTION OF MONUMENT FOR CORNER AND ACCESSORIES ESTABLISHED TO PERPETUATE LOCATING THE POSITION OF THE CORNER:**

Accepted 4" Harrison cast iron monument marked "County Surveyor" as a substantial marker for the section corner and is accepted as a careful and faithful reestablishment of the position of the original corner.

Northwest Corner House S50°E 139.60' #5  
North One Quarter Corner, Section 3, T10N R12W, 4" diameter Harrison cast iron monument with Kent County brass cap, West 349.70' #7  
Power Pole N53°W 62.79' Set spike with tag #22439 in Northeasterly side of pole. #7  
Wood Fence Post S36°E 43.54' Found spike in East side of post. #8  
Telephone Riser N42°E 62.43' top center. #9  
Cut off Pole N23°E 79.27' Found P.K. nail with tag #22439 in West side of pole. #10


Signed by Norman L. Ochs Date August 16, 1999

Surveyor's Michigan License No. 22439

Form approved by Michigan State Board of Land Surveyors, Jan 28, 1971  
Revised May 14, 1975  
Revised Jan., 1983

Approved by Peer Review Group on December 16, 1999  
Norman L. Ochs, County Representative.

*N.L.O.*

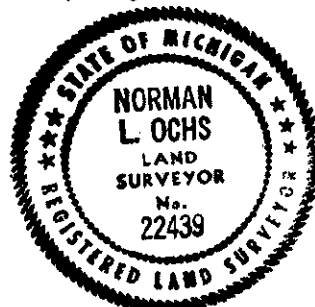

A. Description (cont.)

Norman L. Ochs R.L.S. #22439

LCRC #726 September 25, 1985

Found 5/8" Rod in monument box in centerline of the East and West bituminous road. Road going North is 17 feet West. Also found 1/4" Rod and 17 feet West of monument box. Found 1/8th line fence to East which would match Iron in monument box and found 1/8th line fence to West which would fall 27.00 feet short of monument box. Recommend we honor the 1/4" Rod 17 feet West of monument box, because this is within 4.33 feet of William M. Jacques 1904 distance from the Southeast Corner and fits the centerline of occupation best. Removed 1/4" Rod and set a 4" x 20" Harrison cast iron monument marked "County Surveyor". Also removed 5/8" Rod and old monument box which was 17.76 feet East.

North One Quarter Corner, Section 3, T10N R12W, West 349.69' #6

Power Pole N50°W 62.11' #7

Northwest Corner House S52°E 145.70' (addition on North side). #5

Wood Fence Post S30°E 43.53' #8

Telephone Riser N50°E 62.36' #9

James C. Glaza R.L.S. #40166

Recorded in Liber 364, Page 7089 July 31, 1995

Found County Monument

Witnesses: LCRC #726

Measured 2619.47 feet from the Southwest Corner to the South One Quarter Corner of Section 35.

Norman L. Ochs R.L.S. #22439

September 13, 1995

Found 4" diameter Harrison cast iron monument

Cut off Pole N35°E 79.25' #10

Power Pole N50°W 66.77' #11

Northwest Corner House S52°E 145.42' #5

Wood Fence Post S30°E 43.60' #8

Telephone Riser N50°E 62.40' #9

SURVEY &  
REMONUMENTATION

MAR 13 2000

SECTION