

**SURVEY & REMONUMENTATION**

MAR 19 1998

1997 Newaygo County Remonumentation Project

NEWAYGO COUNTY REGISTER OF DEEDS LINDA M. DROWN

'98 MAR 6 PM 12 34

**LAND CORNER RECORDATION CERTIFICATE FILING REQUIREMENT of Act 74, Mich. P.A. 1970**

**SECTION**

For corners in Newaygo (County) Located in: Corner Code #

1. Public Land Survey T 11N R 12W J-1

2. Property Controlling in Section S T R

3. Miscellaneous Property in Sec. S T R

4. Lot No. \_\_\_\_\_, Recorded Plat \_\_\_\_\_

5. Private Claims \_\_\_\_\_

*Linda M. Brown*

VOL. 2 67

**Register of Deeds Stamp & File Number**

	A	B	C	D	E	F	G	H	I	J	K	L	M
1													
2	6	5	4	3	2	1							
3													
4	7	8	9	10	11	12							
5													
6	18	17	16	15	14	13							
7													
8	19	20	21	22	23	24							
9													
10	30	29	28	27	26	25							
11													
12	31	32	33	34	35	36							
13													

I, Norman L. Ochs, in a field survey on July 8, 19 97, do hereby certify that under requirements of P. A. 74, Michigan P.A. of 1970, the corner points mentioned in lines 1 and 2 above were in conformance with regulations and rules therefore as required in the current manual of survey instructions of the United States Department of the Interior, Bureau of Land Management or by a decree of a Court of Law and/or that the corner points mentioned in lines 3, 4 and 5 above were in conformance with the rules of the Michigan Board of Land Surveyors or by a Decree of a Court of Law; established, re-established, monumented, re-monumented, recovered, found as expressed below:

**Note: Not more than 4 corners, all in the same town and range, may be recorded on this certificate.**

North One Quarter Corner, Section 2, Grant Township, Newaygo County, Michigan

**A. DESCRIPTION OF ORIGINAL MONUMENT AND ACCESSORIES AND/OR SUBSEQUENT RESTORATION:**

- G.L.O. Never set Patrick A. Salisbury R.L.S. #13594 February 25, 1974 Drawing Number 74012AC Found 1" Pipe in intersection 1/2" Pipe, South One Quarter Corner, Section 35, T12N R12W, West 16.50' #2 8" White Oak S30°E 29.3' #3 8" Black Oak S45°W 55.6' #4
- Lyle S. Shepherd R.L.S. #503 August 26, 1924 Book 70 Pages 2 and 3 Wood Stake 24" White Oak Southeast 24' #1 Newaygo Engineering and Survey Company August 2, 1989 Found 1" Pipe raised with 1/2" rod Newaygo Engineering and Survey Company September 7, 1995 Drawing Number's 95211B and 95212B Found 1/2" Rod Power Pole S45°E 91.08' #5 Power Pole S30°W 78.5' #6 16" Black Oak N45°E 29.26' #7 5/8" rod, South One Quarter Corner, Section 35, T12N R12W, West 16.50' #2
- Charles Fricke R.L.S. #21781 January 16, 1996 Liber 363 Page 7291 8" Twin Oak N30°E 29.2' #8 Power Pole S30°E 91.1' #5 Power Pole S25°W 78.1' #6 8" Pine N50°W 49.0' #9

**B. DESCRIPTION OF CORNER EVIDENCE FOUND AND/OR METHOD APPLIED IN RESTORING OR REESTABLISHING CORNER:**

Found 1" X 24" Iron pipe raised with 1/2" X 9" rerod in the centerline of the road going South and the centerline of the East and West road is 2 feet North and the centerline of the road going North is 15 feet West. The condition of the recorded witnesses are: #1 gone, #2 good condition, #3 and #4 gone, #5 and #6 good condition, #7 gone, #8 good condition, #9 dead.

**C. DESCRIPTION OF MONUMENT FOR CORNER AND ACCESSORIES ESTABLISHED TO PERPETUATE LOCATING THE POSITION OF THE CORNER:**

Removed 1" X 24" Iron pipe and 1/2" X 9" rerod and set a 4" diameter Harrison cast iron monument 36" long marked "County Surveyor" as a substantial marker for the section corner and is accepted as a careful and faithful reestablishment of the original corner.


- 1/2" Pipe, South One Quarter Corner, Section 35, T12N R12W, West 16.54' #2
- Power Pole S25°E 91.09' Found nail and tag #13603 in Southwest side of pole. #5
- Power Pole S32°E 78.18' Found p.k. and tag #22439 in West side of pole. #6
- 12"-10" Twin Black Oak N41°E 29.28' Found Spike in Northwest Side of tree. #8

Signed by Norman L. Ochs Date September 8, 1997

Surveyor's Michigan License No. 22439

Approved by Peer Review Group on September 9, 1997  
Norman L. Ochs, County Representative.

*N.L.O.*

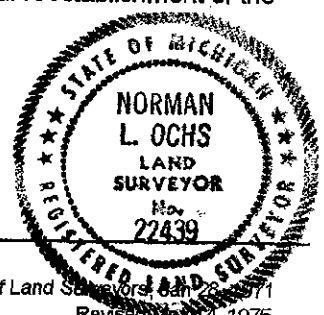

Form approved by Michigan State Board of Land Surveyors, Jan 28, 1971 Revised May 14, 1975 Revised Jan., 1983