

**SURVEY & REMONUMENTATION**

**MAR 13 2000**

**1999 Newaygo County Remonumentation Project**

**NEWAYGO COUNTY REGISTER OF DEEDS LINDA M. BROWN**

**SECTION**

**LAND CORNER RECORDATION CERTIFICATE**

**FILING REQUIREMENT of Act 74, Mich. P.A. 1970**

**00 FEB 28 PM 1 10**

*Linda M. Brown*

**VOL. 2**

**303**

**Register of Deeds Stamp & File Number**

	A	B	C	D	E	F	G	H	I	J	K	L	M
1													
2	6		5		4		3		2		1		
3													
4	7		8		9		10		11		12		
5													
6	18		17		16		15		14		13		
7													
8	19		20		21		22		23		24		
9													
10	30		29		28		27		26		25		
11													
12	31		32		33		34		35		36		
13													

For corners in Newaygo (County) Located in: \_\_\_\_\_ Corner Code # \_\_\_\_\_

1. Public Land Survey T 11N R 12W K-13  
 T \_\_\_\_\_ R \_\_\_\_\_  
 T \_\_\_\_\_ R \_\_\_\_\_  
 T \_\_\_\_\_ R \_\_\_\_\_

2. Property Controlling in Section S \_\_\_\_\_ T \_\_\_\_\_ R \_\_\_\_\_  
 S \_\_\_\_\_ T \_\_\_\_\_ R \_\_\_\_\_

3. Miscellaneous Property in Sec. S \_\_\_\_\_ T \_\_\_\_\_ R \_\_\_\_\_  
 S \_\_\_\_\_ T \_\_\_\_\_ R \_\_\_\_\_

4. Lot No. \_\_\_\_\_, Recorded Plat \_\_\_\_\_

5. Private Claims \_\_\_\_\_

I, Norman L. Ochs, in a field survey on February 12, 1999, do hereby certify that under requirements of P. A. 74, Michigan P.A. of 1970, the corner points mentioned in lines 1 and 2 above were in conformance with regulations and rules therefore as required in the current manual of survey instructions of the United States Department of the Interior, Bureau of Land Management or by a decree of a Court of Law and/or that the corner points mentioned in lines 3, 4 and 5 above were in conformance with the rules of the Michigan Board of Land Surveyors or by a Decree of a Court of Law; established, re-established, monumented, re-monumented, recovered, found as expressed below:

**Note: Not more than 4 corners, all in the same town and range, may be recorded on this certificate.**

Southeast Corner, Section 35, Grant Township, Newaygo County, Michigan.

**A. DESCRIPTION OF ORIGINAL MONUMENT AND ACCESSORIES AND/OR SUBSEQUENT RESTORATION:**

G.L.O. N. Brookfield 1836  
 18" Black Ash N28°E 32 Links (21.12') #1  
 12" Maple N44°W 29 Links (19.14') #2

William M. Jacques (County Surveyor)  
 Book 8, Pages 50 thru 52 October 10, 1904  
 Measured 78 Chains 60 feet (5208') from to Southeast Corner to the Southwest Corner and measured 80 Chains (5280') from the Southeast Corner to the Northeast Corner and measured 40 Chains 44 feet (2684') from the Southeast Corner to the East One Quarter Corner all in Section 35.

William M. Jacques (County Surveyor)  
 Book 8, Page 31 1903 ±  
 Measured 80 Chains 11 feet (5291') from the Southwest Corner to the Southeast Corner of Section 36.

Lyle S. Shepherd R.L.S. #503  
 Witness Book Number 2, Page 156  
 2" Iron  
 Elm S75°E 68.6' #3  
 Telephone Pole S30°E 44.0' #4  
 Elm S25°E 25.9' #5

Norman L. Ochs R.L.S. #22439  
 July 29, 1982 Found ¾" Pipe  
 North One Quarter Corner, Section 2, T10N R12W,  
 West 284.40' #6  
 8" Elm N35°E 50.58' #7  
 5" - 5" Twin Elm S35°W 37.86' #8  
 3" Street Sign N45°W 39.15' #9

OVER ↙

**B. DESCRIPTION OF CORNER EVIDENCE FOUND AND/OR METHOD APPLIED IN RESTORING OR REESTABLISHING CORNER:**

Found 4" Harrison cast iron monument marked "County Surveyor". The centerline of the East and West bituminous road is 2 feet South and the centerline of the bituminous road going North is 2 feet West. The condition of the recorded witnesses are: #1 thru #5 gone, #6 good condition, #7 thru #10 gone, #11 good condition.

**C. DESCRIPTION OF MONUMENT FOR CORNER AND ACCESSORIES ESTABLISHED TO PERPETUATE LOCATING THE POSITION OF THE CORNER:**

Accepted 4" Harrison cast iron monument marked "County Surveyor" as a substantial marker for the section corner and is accepted as a careful and faithful reestablishment of the original corner.

North One Quarter Corner, Section 2, Tyrone Township, (Monument with Kent County brass cap) West 284.40' #6  
 Centerline of road going North is 2' West. #11  
 8" Elm S43°W 49.79' Set spike with tag #22439 in Northwesterly side of tree.  
 6" Elm N48°W 52.97' Set spike with tag #22439 in Southwesterly side of tree.  
 14" Elm S37°E 56.83' Set spike with tag #22439 in West side of tree.


Signed by Norman L. Ochs Date August 16, 1999

Surveyor's Michigan License No. 22439

Form approved by Michigan State Board of Land Surveyors, Mr. 28, 1999

Approved by Peer Review Group on August 19, 1999  
 Norman L. Ochs, County Representative.

*N.L.O.*

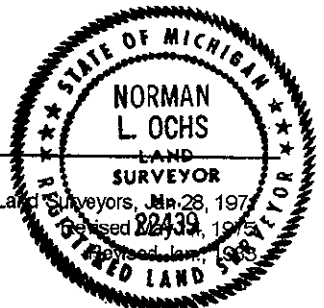

A. Description (cont.)

Norman L. Ochs R.L.S. #22439

LCRC #684 June 26, 1985

Found  $\frac{3}{4}$ " Pipe in centerline of the East and West road and the centerline of the road going North is 2 feet West. Removed Pipe and set a 4" x 20" Harrison cast iron monument marked "County Surveyor".

8" Elm N35°E 50.58' #7

5" - 5" Twin Elm S35°W 37.86' #8

Street Sign N45°W 39.18' #9

5" Elm S20°E 38.07' #10

Centerline of road going North West 2.0' #11

James J. Keller R.L.S. #10693

March 12, 1991

Measured 2635.71 feet from the Southwest Corner to the South One Quarter Corner of Section 36 and measured 5273.17 feet from the Southwest Corner to the Southeast Corner of Section 36.

SURVEY &  
REMONUMENTATION

MAR 13 2000

SECTION