

**SURVEY &
REMONUMENTATION**

MAR 19 1998

1997 Newaygo County Remonumentation Project

**NEWAYGO COUNTY
REGISTER OF DEEDS
LINDA M. BROWN**

SECTION

**LAND CORNER RECORDATION CERTIFICATE
FILING REQUIREMENT of Act 74, Mich. P.A. 1970**

'98 MAR 6 PM 12 31

Linda M. Brown

For corners in Newaygo Located in: _____ Corner Code # _____
(County)

1. Public Land Survey T 11N R 13W _____ F-3 _____
T _____ R _____
T _____ R _____
T _____ R _____

2. Property Controlling S _____ T _____ R _____
in Section S _____ T _____ R _____

3. Miscellaneous S _____ T _____ R _____
Property in Sec. S _____ T _____ R _____

4. Lot No. _____, Recorded Plat _____

5. Private Claims _____

VOL. 2

64

Register of Deeds Stamp & File Number

	A	B	C	D	E	F	G	H	I	J	K	L	M
1													
2	6		5		4		3		2		1		
3													
4	7		8		9		10		11		12		
5													
6	18		17		16		15		14		13		
7													
8	19		20		21		22		23		24		
9													
10	30		29		28		27		26		25		
11													
12	31		32		33		34		35		36		
13													

I, Norman L. Ochs, in a field survey on September 17, 1997, do hereby certify that under requirements of P. A. 74, Michigan P.A. of 1970, the corner points mentioned in lines 1 and 2 above were in conformance with regulations and rules therefore as required in the current manual of survey instructions of the United States Department of the Interior, Bureau of Land Management or by a decree of a Court of Law and/or that the corner points mentioned in lines 3, 4 and 5 above were in conformance with the rules of the Michigan Board of Land Surveyors or by a Decree of a Court of Law, established, re-established, monumented, re-monumented, recovered, found as expressed below:

Note: Not more than 4 corners, all in the same town and range, may be recorded on this certificate.

South One Quarter Corner, Section 4, Ashland Township, Newaygo County, Michigan.

A. DESCRIPTION OF ORIGINAL MONUMENT AND ACCESSORIES AND/OR SUBSEQUENT RESTORATION;

G.L.O. James H. Mullett 1838
12" Beech N54°E 10 Links (6.60') #1
12" White Ash N60°W 14 Links (9.24') #2

Winfield S. Merrill (County Surveyor)
Book A Page 71 June 10, 1882
18" Pine N54°W 33 Links (21.78') #3

Ralph A. Smith R.L.S. #3421
Lyle Shepherd's Witness Book Number 2 Page 149
Book 70 Page 131 1951 1" Pipe and broken clay tile
12" Elm N65°±E 52.5' #4
12" White Oak (U.S.G.S. El. 750.5') S35°±E 47.3' #5

Newaygo Engineering and Survey Company
January 5, 1978 Drawing Number 78002M
Found nothing in road. Found one witness with spike in face.
Set P.K. for temporary corner.
12" White Oak S35°E 47.3' #5

OVER

B. DESCRIPTION OF CORNER EVIDENCE FOUND AND/OR METHOD APPLIED IN RESTORING OR REESTABLISHING CORNER:

Found 1/2" X 1" Square Iron 25" long and found red broken clay tile 26" under road bed. The centerline of East and West gravel road is 2.5 feet North and the centerline of gravel road going South is 4 feet East and in the centerline of gravel road going North. The condition of the recorded witnesses are: #1 thru #4 gone, #5 and #6 good condition, #7 gone, #8 and #9 good condition.

C. DESCRIPTION OF MONUMENT FOR CORNER AND ACCESSORIES ESTABLISHED TO PERPETUATE LOCATING THE POSITION OF THE CORNER:

Removed 1/2" X 1" Iron and set a 4" diameter Harrison cast iron monument 20" long with broken red clay tile around it, marked "County Surveyor" as a substantial marker for the section corner and is accepted as a careful and faithful reestablishment of the original corner.


24" White Oak Stump S30°E 48.10' to center. #5
40" White Oak N02°W 234.96' Set spike and tag #22439 in East side of tree. #6
24" White Pine S24°E 106.18' Found spike and tag #22439 in Southwest side of tree. #8
Power Pole N51°W 104.64' Found spike in Southeast side of pole. #9
15"-10" Twin Maple S68°E 75.47' Set spike and tag in North side of tree.

Signed by Norman L. Ochs Date October 10, 1997
Norman L. Ochs

Surveyor's Michigan License No. 22439 Form approved by Michigan State Board of Land Surveyors, 1971

Approved by Peer Review Group on October 14, 1997
Norman L. Ochs, County Representative.

N.L.O.

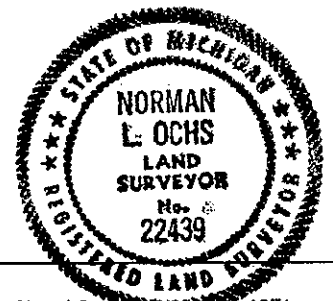

Revised May 14, 1975
Revised Jan., 1983

A. Description (cont.)

Thomas W. Chettleburgh R.L.S. #16036

LCRC #715 November 1, 1985 Set Square Iron Bar over

Found three pieces of broken clay tile 2.8 feet deep. Centerline of North and South gravel road is two feet East and the centerline of the East and West gravel road is 3 feet North.

17" Oak S30°E 48.51' #5

21" Oak N03°W 235.88' #6

14" Oak S68°E 137.60' #7

14" Pine S26°E 106.21' #8

Power Pole S48°W 104.70' #9

Newaygo Engineering and Survey Company

1989 Found Square Iron Bar 1/2" X 3/4"

28" White Oak N03°W 235.88' #6

14" Oak S68°E 137.67' #7

17" White Oak S30°E 48.50' #5

14" White Pine S26°E 106.15' #8

Power Pole S48°W 104.68' #9

Newaygo Engineering and Survey Company

Drawing Number 95242B October 17, 1995

Found Square Iron Bar 1/2" X 3/4"

14" Oak S68°E 137.67' #7

17" Oak S30°E 48.50' #5

14" White Pine S26°E 106.15' #8

Power Pole S48°W 104.69' #9