

MAR 13 2000

SECTION

1999 Newaygo County Remonumentation Project

NEWAYGO COUNTY REGISTER OF DEEDS

JUDITH A. M. BROWN

LAND CORNER RECORDATION CERTIFICATE FEB 28 PM 1 09 FILING REQUIREMENT of Act 74, Mich. P.A. 1970

For corners in Newaygo (County) Located in: Corner Code # 1. Public Land Survey T 11N R 12W T 11N R 13W T R T R 2. Property Controlling in Section S T R S T R 3. Miscellaneous Property in Sec. S T R S T R 4. Lot No. , Recorded Plat 5. Private Claims

Linda M. Brown

VOL. 2

291

Register of Deeds Stamp & File Number

Grid table with columns A-M and rows 1-13. Contains numbers 6-36 in a grid pattern.

I, Norman L. Ochs, in a field survey on February 19, 1999, do hereby certify that under requirements of P. A. 74, Michigan P.A. of 1970, the corner points mentioned in lines 1 and 2 above were in conformance with regulations and rules therefore as required in the current manual of survey instructions of the United States Department of the Interior, Bureau of Land Management or by a decree of a Court of Law and/or that the corner points mentioned in lines 3, 4 and 5 above were in conformance with the rules of the Michigan Board of Land Surveyors or by a Decree of a Court of Law, established, re-established, monumented, re-monumented, recovered, found as expressed below.

Note: Not more than 4 corners, all in the same town and range, may be recorded on this certificate.

Southwest Corner, Section 31, Grant Township, Newaygo County, Michigan. Southeast Corner, Section 36, Ashland Township, Newaygo County, Michigan.

A. DESCRIPTION OF ORIGINAL MONUMENT AND ACCESSORIES AND/OR SUBSEQUENT RESTORATION:

G.L.O. N. Brookfield 1836 12" Beech N22°E 20 Links (13.2')#1 18" Maple N44°W 45 Links (29.7')#2

Delos G. Anderson (County Surveyor) 1895 - 1902 Book A, Pages 345 and 346 Iron Rod 1/2" thick 4 feet long for corner

Norman L. Ochs R.L.S. #22439 September 11, 1985 Drawing Numbers 85001 and 85002 LCRC #675 Found 3/4" Angle Iron in centerline of the East and West gravel road and the tree line going North is 5 feet East. Removed Angle Iron and set a 4" x 20" Harrison cast iron monument marked "County Surveyor". 26" Maple N10°E 50.75' #3 16" Maple N60°E 69.12' #4 40" Maple N35°W 26.48' #5 1" - 5" Clump Elm S30°E 21.04' #6

Norman L. Ochs R.L.S. #22439 May 6, 1997 Drawing Number 97082B Found 4" Harrison cast iron monument 26" Maple N10°E 50.75' #3 16" Maple N60°E 69.12' #4 40" Maple N35°W 26.48' #5 1" - 5" Clump Elm S30°E 21.04' #6

B. DESCRIPTION OF CORNER EVIDENCE FOUND AND/OR METHOD APPLIED IN RESTORING OR REESTABLISHING CORNER:

Found 4" Harrison cast iron monument marked "County Surveyor" 0.7 feet below grade and in the centerline of the East and West bituminous road and on line with tree row going North.. The centerline of the North and South bituminous road is 30 feet East. The condition of the recorded witnesses are: #1 and #2 gone, #3 good condition, #4 thru #6 gone.

C. DESCRIPTION OF MONUMENT FOR CORNER AND ACCESSORIES ESTABLISHED TO PERPETUATE LOCATING THE POSITION OF THE CORNER:

Accepted 4" Harrison cast iron monument marked "County Surveyor" as a substantial marker for the section corner and is accepted as a careful and faithful reestablishment of the original corner.


36" Maple N08°E 50.80' Found spike in East side of tree. #3 South end 12" Corrugated Metal Pipe S65°E 89.90' to centerline. North end 12" Corrugated Metal Pipe N80°E 92.93' to centerline. West end 12" Black Culvert N35°W 26.45' to centerline.

Signed by Norman L. Ochs Date August 16, 1999

Surveyor's Michigan License No. 22439

Form approved by Michigan State Board of Land Surveyors, established 1975

Approved by Peer Review Group on August 19, 1999 Norman L. Ochs, County Representative.

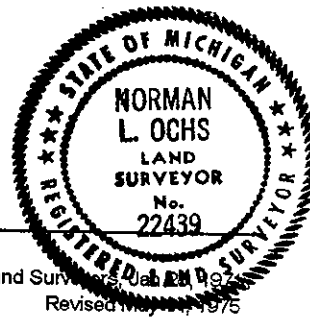

Revised May 1975 Revised Jan., 1983

N.L.O.