

SURVEY & REMONUMENTATION

DEC 07 2000

1993 NEWAYGO COUNTY REMONUMENTATION PROJECT

NEWAYGO COUNTY REGISTER OF DEEDS MARLENE TOOGOOD

SECTION

LAND CORNER RECORDATION CERTIFICATE
Filing Requirement of Act 74, Mich. P.A. 1970

'94 JAN 21 PM 3 24

Marlene Toogood

For corners in Newaygo (County) Located In: Corner Code ##

1. Public Land Survey	T <u>11N</u> R <u>14W</u>	<u>A-1</u>
	T _____ R _____	_____
	T _____ R _____	_____
	T _____ R _____	_____
2. Property Controlling in Section	S _____ T _____ R _____	_____
	S _____ T _____ R _____	_____
3. Miscellaneous Property in Sec.	S _____ T _____ R _____	_____
	S _____ T _____ R _____	_____

VOL 001 PAGE 01

Register of Deeds Stamp & File Number

4. Lot No. _____, Recorded Plat _____
5. Private Claims _____

	A	B	C	D	E	F	G	H	I	J	K	L	M
2	6	5	4	3	2	1							
3													
4	7	8	9	10	11	12							
5													
6	16	17	16	15	14	13							
7													
8	19	20	21	22	23	24							
9													
10	30	29	28	27	26	25							
11													
12	31	32	33	34	35	36							
13													

Norman L. Ochs, in a field survey on October 16, 1993, do hereby certify that under requirements of P.A. 74, Michigan P.A. of 1970, the corner points mentioned in lines 1 and 2 above were in conformance with regulations and rules therefore as required in the current manual of survey instructions of the United States Department of the Interior, Bureau of Land Management or by a decree of a Court of Law and/or that the corner points mentioned in lines 3, 4 and 5 above were in conformance with the rules of the Michigan Board of Land Surveyors or by a Decree of a Court of Law, established, re-established, monumented, re-monumented, recovered, found as expressed below:

NOTE: Not more than 4 corners, all in the same town and range, may be recorded on this certificate.

NW Corner, Section 6, Bridgeton Twp., Newaygo County, Michigan

A. Description of original monument and accessories and/or subsequent restoration:

- | | |
|--------------------------------|---|
| G.L.O. John Mullett 1837 | R. A. Smith, RLS#3421 M.S.H.D. |
| #1 12" Beech S75°E 37 links | Nov. 7, 1950 Sept. 3, 1964 |
| #2 14" Beech N45°W 25 links | 1" gas Pipe Tacked Hub over axle shaft in Mon. Box |
| | 20" Maple NW. 47.2' 32" Hickory N45°W 47.32' #9 |
| | #48" Walnut NE. 48.9' Power Pole S65°W 56.96' #10 |
| N.C.R.C. Sheet | #320" Elm SE. 43.3' Power Pole and Tele. Pole N55°E 61.72' #1 |
| Plow Point 18" Maple NW. 46.7' | |
| Tele. Pole NE. 32.7 feet #6 | |
| 28" Beech SW. 37.9' #7 | |
| 12" Elm SE. 43.2' #5 | |

(see over)-----

B. Description of corner evidence found and/or method applied in restoring or reestablishing corner:

A-1 Sec. Cor, NW Corner, Section 6, T11N, R14W.

Found 4" Harrison Cast Iron Monument in Monument Box 7 feet East of the centerline of the North and South Road and 4 feet North of the East and West Road.

Found cast iron mon. in good condition. Condition of recorded witnesses is:

#1 thru #12 gone, #12 good condition, #13 gone, #14, gone, #15 good condition, #16 good condition.

I am aware that there is not a positive chain of evidence for this corner. With that in mind I have searched for any other conflicting evidence that would indicate an alternate location. Finding none I accept the Harrison monument as a careful and faithful re-establishment of the position of the original corner.

C. Description of monument for corner and accessories established to perpetuate locating the position of the corner:

Newaygo Engineering and Survey Co.


Found 4" Harrison Cast Iron Monument in Monument Box and accepted as a substantial marker for the NW corner and is accepted as a careful and faithful reestablishment of the position of the original corner.

Fence Post S66°W 65.58' Nail in North side

Top Center of R/W Post N60°W 67.31'

Fence Post N55°E 53.19' Nail in SE. side

Fence Post S48°E 53.98' Nail In top

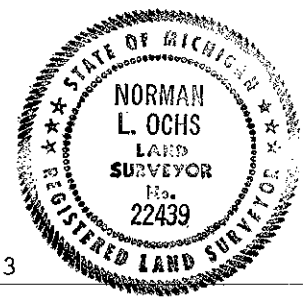

Signed by Norman L. Ochs

Date November 8, 1993

Surveyor's Michigan License No. #22439

Approved by Peer Review Group Dec. 21, 1993
Norman L. Ochs, County Representative

A. cont.

Muskegon Co, Rd, Comm. P.A. Salisbury, RLS#13594
1-1/2" Iron Pipe 1/22/68 Fnd mon. box 7' E CL Rd. Box
8" Locust NE 49.0' #3
15" Maple NW 47.0' #4
8" Elm SE 43.5' #5

6-10-82 Chas. E. Lewandowski, RLS #7867
Set 4" x 20" Cast iron mon. w/co. Surveyor Legend
in mon. box
Fe Post N35°E 53.33' #12
12" Cherry N72°W 83.09' #13
18" Hickory S18°E 87.30' #14
Recorded in Liber 1240 Pg. 522

M.D.O.T. Newaygo Co. R.O.W. Book
Shows corner 10.73' East of Design CL.

John E. Lazarock, RLS #13587 July, 1983
Set 4" County Surveyors Mon. in Mon. box.
10" Choke Cherry NW 83.15' #13
Fe. Post NE 53.21' #12
Cor. Fe. Post SE 53.94' #15
15" Hickory SSE 87.33' #14
Cor. Fe Post SW 65.55' #16
Recorded in Liber 1270 Page 678.

**SURVEY &
REMONUMENTATION**

JEC 07 2000

SECTION