

SURVEY & REMONUMENTATION

MAR 19 1998

1997 Newaygo County Remonumentation Project

NEWAYGO COUNTY
REGISTER OF DEEDS
LINDA M. BROWN

SECTION

LAND CORNER RECORDATION CERTIFICATE
FILING REQUIREMENT of Act 74, Mich. P.A. 1970

'98 MAR 6 PM 12 33

For corners in Newaygo (County) Located in: Corner Code #

1. Public Land Survey T 11N R 14W C-1
 T ___ R ___
 T ___ R ___
 T ___ R ___

2. Property Controlling in Section S ___ T ___ R ___
 S ___ T ___ R ___

3. Miscellaneous Property in Sec. S ___ T ___ R ___
 S ___ T ___ R ___

4. Lot No. _____, Recorded Plat _____

5. Private Claims _____

Linda M. Brown

VOL. 2 55

Register of Deeds Stamp & File Number

	A	B	C	D	E	F	G	H	I	J	K	L	M
1													
2	6		5		4		3		2		1		
3													
4	7		8		9		10		11		12		
5													
6	18		17		16		15		14		13		
7													
8	19		20		21		22		23		24		
9													
10	30		29		28		27		26		25		
11													
12	31		32		33		34		35		36		
13													

I, Norman L. Ochs, in a field survey on April 1, 1997, do hereby certify that under requirements of P. A. 74, Michigan P.A. of 1970, the corner points mentioned in lines 1 and 2 above were in conformance with regulations and rules therefore as required in the current manual of survey instructions of the United States Department of the Interior, Bureau of Land Management or by a decree of a Court of Law and/or that the corner points mentioned in lines 3, 4 and 5 above were in conformance with the rules of the Michigan Board of Land Surveyors or by a Decree of a Court of Law; established, re-established, monumented, re-monumented, recovered, found as expressed below:

Note: Not more than 4 corners, all in the same town and range, may be recorded on this certificate.

Northwest Corner, Section 5, Bridgeton Township, Newaygo County, Michigan

A. DESCRIPTION OF ORIGINAL MONUMENT AND ACCESSORIES AND/OR SUBSEQUENT RESTORATION:

G.L.O. N. Brookfield 1858
 18" Beech S51°E 41 Links (27.06')#1
 20" Beech S60°W 61 Links (40.26')#2

Winfield S. Merrill (County Surveyor)
 Book A Pages 31 and 32 1881
 12" Beech S82°W 295 Links (194.70')#3

Lyle S. Shepherd R.L.S. #503
 November 7, 1950 Book 56 Page 43
 1" Gas Pipe
 Southeast Corner Store N45°W 32.6' #4
 Northeast Corner Church S45°W 59.5' #5
 Post S45°E 42.9' #6

Patrick A. Salisbury R.L.S. #13594
 December 1967 Consumers Power Company Section Break
 Found 1½" Pipe West side of road
 Southeast Corner Store N35°W 32.4' #4
 Power Pole S45°W 41.3' #8
 Northeast Corner Church steps N45°W 54.3' #7

B. DESCRIPTION OF CORNER EVIDENCE FOUND AND/OR METHOD APPLIED IN RESTORING OR REESTABLISHING CORNER:

Found 1½" Pipe (21" long) over a 1" Pipe (3 feet long) connected together over 1/8" X 1¼" Iron in centerline of road going East and the centerline of the North and South road is 7 feet East and centerline of road going West is 1.5 feet South. The condition of the recorded witnesses are: #1 thru #4 gone, #5 good condition, #6 and #7 gone, #8 good condition.

C. DESCRIPTION OF MONUMENT FOR CORNER AND ACCESSORIES ESTABLISHED TO PERPETUATE LOCATING THE POSITION OF THE CORNER:


Removed 1¼" Pipe and 1" Pipe and set a 4" diameter Harrison cast iron monument 17" long over 1/8" X 1¼" Iron, marked "County Surveyor" as a substantial marker for the section corner and is accepted as a careful and faithful reestablishment of the original corner.

Northeast Corner Church (Sitka United Methodist Church) S50°W 59.45' #5
 Power Pole S36°E 41.35' Set spike and tag in Northeast side of pole. #8
 Southeast Corner Attached Garage House #8827 N62°W 153.15'
 Northwest Corner Church S68°W 88.65'
 ¾" Angle Iron, Southwest Corner, Section 31, T12N R14W, East 32.29'

Signed by Norman L. Ochs Date September 8, 1997
 Norman L. Ochs

Surveyor's Michigan License No. 22439

Form approved by Michigan State Board of Land Surveyors, 1997

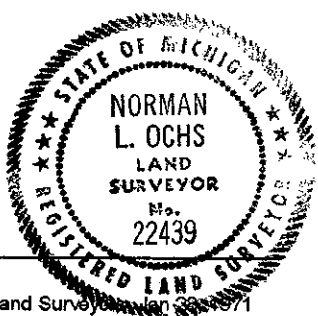

Approved by Peer Review Group on September 9, 1997
 Norman L. Ochs, County Representative.

N.L.O.

Revised May 14, 1975
 Revised Jan., 1983