

SURVEY & REMONUMENTATION

MAR 19 1998

1997 Newaygo County Remonumentation Project

NEWAYGO COUNTY
REGISTER OF DEEDS
LINDA M. BROWN

'98 MAR 6 PM 12 33

SECTION

**LAND CORNER RECORDATION CERTIFICATE
FILING REQUIREMENT of Act 74, Mich. P.A. 1970**

For corners in
Newaygo
(County)

Located in: _____ Corner Code # _____

1. Public Land Survey T 11N R 14W _____ C-2 _____
T _____ R _____
T _____ R _____
T _____ R _____

2. Property Controlling S _____ T _____ R _____
in Section S _____ T _____ R _____

3. Miscellaneous S _____ T _____ R _____
Property in Sec. S _____ T _____ R _____

4. Lot No. _____, Recorded Plat _____

5. Private Claims _____

Linda M. Brown

VOL. 2

56

Register of Deeds Stamp & File Number

	A	B	C	D	E	F	G	H	I	J	K	L	M
1													
2	6	●	5	4	3	2	1						
3													
4	7	8	9	10	11	12							
5													
6	18	17	16	15	14	13							
7													
8	19	20	21	22	23	24							
9													
10	30	29	28	27	26	25							
11													
12	31	32	33	34	35	36							
13													

I, Norman L. Ochs, in a field survey on March 31, 1997, do hereby certify that under requirements of P. A. 74, Michigan P.A. of 1970, the corner points mentioned in lines 1 and 2 above were in conformance with regulations and rules therefore as required in the current manual of survey instructions of the United States Department of the Interior, Bureau of Land Management or by a decree of a Court of Law and/or that the corner points mentioned in lines 3, 4 and 5 above were in conformance with the rules of the Michigan Board of Land Surveyors or by a Decree of a Court of Law; established, re-established, monumented, re-monumented, recovered, found as expressed below:

Note: Not more than 4 corners, all in the same town and range, may be recorded on this certificate.

West One Quarter Corner, Section 5, Bridgeton Township, Newaygo County, Michigan

A. DESCRIPTION OF ORIGINAL MONUMENT AND ACCESSORIES AND/OR SUBSEQUENT RESTORATION:

G.L.O. John Mullett 1837 12" Beech Corner	Lyle S. Shepherd R.L.S. #503 Witness Book Number 2 Page 136 8" Maple West on line 26.8' #1
Winfield S. Merrill (County Surveyor) Book A Pages 31 and 32 1881 Found old corner Iron Stake	Ralph A. Smith R.L.S. #3421 Book 56 Page 43 November 7, 1950 Iron
Newaygo County Road Commission Sheet 1 1/2" Pipe 24" Maple N65°E 49.6' #2 18" Maple West 26.4' #1 18" Maple N25°W 68.9' #3	18" Maple West 26.4' #1 24" Maple N65°E 49.6' #2

OVER ↴

B. DESCRIPTION OF CORNER EVIDENCE FOUND AND/OR METHOD APPLIED IN RESTORING OR REESTABLISHING CORNER:

Found 3/8" X 1 1/2" Iron with hole at top, raised with 3/4" twist iron and wooden stake raised with 1 1/4" Pipe in the centerline of gravel road going East and the centerline of North and South gravel road is 4 feet East and on fence line going West. The condition of the recorded witnesses are: #1 thru #3 good condition.

C. DESCRIPTION OF MONUMENT FOR CORNER AND ACCESSORIES ESTABLISHED TO PERPETUATE LOCATING THE POSITION OF THE CORNER:

Removed 3/4" twist iron, wood stake and 1 1/4" Pipe and set a 4" diameter Harrison cast iron monument 20" long marked "County Surveyor" over 3/8" X 1 1/2" Iron as a substantial marker for the section corner and is accepted as a careful and faithful reestablishment of the original corner.

42" Maple N85°W 27.32' Set spike and tag in North side of tree. #1
42" Maple N70°E 51.21' Set spike and tag in South side of tree. #2
42" Maple N15°W 69.76' Set spike and tag in Southwest side of tree. #3
4" Maple S70°E 79.04' Set spike and tag in Northeast side of tree.


Signed by Norman L. Ochs Date September 8, 1997
Norman L. Ochs

Surveyor's Michigan License No. 22439

Form approved by Michigan State Board of Land Surveyors, Jan 28, 1971

Approved by Peer Review Group on September 9, 1997
Norman L. Ochs, County Representative.

N.L.O.

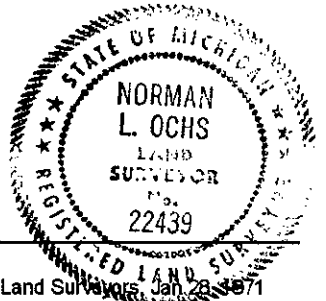

Revised May 14, 1975
Revised Jan., 1983

A. Description (cont.)

Patrick A. Salisbury R.L.S. #13594
December 1967 Consumers Power Company Section Break
Found 1½" Pipe 3 feet West of centerline of pavement
18" Maple N25°W 68.9' #3
20" Maple N60°E 49.4' #2
18" Maple West 26.3' #1