

SURVEY & REMONUMENTATION

MAR 19 1998

1997 Newaygo County Remonumentation Project

NEWAYGO COUNTY
REGISTER OF DEEDS
LINDA M. BROWN

SECTION

LAND CORNER RECORDATION CERTIFICATE
FILING REQUIREMENT of Act 74, Mich. P.A. 1970

'98 MAR 6 PM 12 34

For corners in
Newaygo
(County)

Located in:

Corner Code #

Linda M. Brown

- | | | |
|------------------------------------|-----------------------------|------------|
| 1. Public Land Survey | T <u>11</u> N R <u>14</u> W | <u>C-3</u> |
| | T ___ R ___ | _____ |
| | T ___ R ___ | _____ |
| | T ___ R ___ | _____ |
| 2. Property Controlling in Section | S ___ T ___ R ___ | _____ |
| | S ___ T ___ R ___ | _____ |
| 3. Miscellaneous Property in Sec. | S ___ T ___ R ___ | _____ |
| | S ___ T ___ R ___ | _____ |

VOL. 2

57

Register of Deeds Stamp & File Number

| | A | B | C | D | E | F | G | H | I | J | K | L | M |
|----|----|---|----|---|----|---|----|---|----|---|----|---|---|
| 1 | | | | | | | | | | | | | |
| 2 | 6 | | 5 | | 4 | | 3 | | 2 | | 1 | | |
| 3 | | | ● | | | | | | | | | | |
| 4 | 7 | | 8 | | 9 | | 10 | | 11 | | 12 | | |
| 5 | | | | | | | | | | | | | |
| 6 | 18 | | 17 | | 16 | | 15 | | 14 | | 13 | | |
| 7 | | | | | | | | | | | | | |
| 8 | 19 | | 20 | | 21 | | 22 | | 23 | | 24 | | |
| 9 | | | | | | | | | | | | | |
| 10 | 30 | | 29 | | 28 | | 27 | | 26 | | 25 | | |
| 11 | | | | | | | | | | | | | |
| 12 | 31 | | 32 | | 33 | | 34 | | 35 | | 36 | | |
| 13 | | | | | | | | | | | | | |

I, Norman L. Ochs, in a field survey on April 1, 19 97, do hereby certify that under requirements of P. A. 74, Michigan P.A. of 1970, the corner points mentioned in lines 1 and 2 above were in conformance with regulations and rules therefore as required in the current manual of survey instructions of the United States Department of the Interior, Bureau of Land Management or by a decree of a Court of Law and/or that the corner points mentioned in lines 3, 4 and 5 above were in conformance with the rules of the Michigan Board of Land Surveyors or by a Decree of a Court of Law, established, re-established, monumented, re-monumented, recovered, found as expressed below.

Note: Not more than 4 corners, all in the same town and range, may be recorded on this certificate.

Southwest Corner, Section 5, Bridgeton Township, Newaygo County, Michigan

A. DESCRIPTION OF ORIGINAL MONUMENT AND ACCESSORIES AND/OR SUBSEQUENT RESTORATION:

G.L.O. John Mullett 1837
18" Beech S58°W 32 Links (21.12') #1
18" Beech N33°W 43 Links (28.38') #2

Ralph A. Smith R.L.S. #3421
Book 56 Page 43 November 7, 1950
1 1/4" Pipe
24" Elm N28°E 72.6' #3
24" Elm S33°E 64.1' #4

John C. Brewster (County Surveyor)
Book A Page 6 June 30, 1875 Set post
10" Elm N28 1/4°E 73' #3
14" Elm S32 1/2°E 65' #4

Newaygo County Road Commission Sheet
1/2" Pipe
28" Elm N28°E 72.1' #3
28" Elm S33°E 63.5' #4
6" Twin Maple S60°W 71.0' #5

OVER

B. DESCRIPTION OF CORNER EVIDENCE FOUND AND/OR METHOD APPLIED IN RESTORING OR REESTABLISHING CORNER:

Found 1/2" Iron over 1 1/4" Pipe over 1/2" 25" long twist rod in centerline of North and South bituminous road and in the centerline of bituminous road going West and on fence line going East. The condition of the recorded witnesses are: #1 thru #5 gone, #6 good condition.

C. DESCRIPTION OF MONUMENT FOR CORNER AND ACCESSORIES ESTABLISHED TO PERPETUATE LOCATING THE POSITION OF THE CORNER:

Removed 1/2" Iron, 1 1/4" Pipe and 1/2" twist rod and set a 4" diameter Harrison cast iron monument 20" long marked "County Surveyor" as a substantial marker for the section corner and is accepted as a careful and faithful reestablishment of the original corner.

Centerline of street sign N42°W 46.02' #6
10" Cherry S30°E 62.88' Found spike in West side of tree.
8" Apple S20°W 111.74' Set spike and tag #22439 in East side of tree.
Southeast Corner Covered Porch, House #10365 N28°W 224.17'
Northwest Corner Trailer Home (Block Foundation) S55°E 144.14'

Signed by Norman L. Ochs


Date September 8, 1997

Surveyor's Michigan License No. 22439

Form approved by Michigan State Board of Land Surveyors, Jan 28, 1971
Revised May 14, 1975
Revised Jan., 1983

Approved by Peer Review Group on September 9, 1997
Norman L. Ochs, County Representative.

N.L.O.

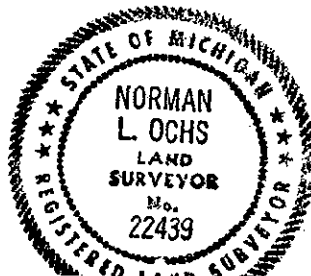

A. Description (cont.)

Patrick A. Salisbury R.L.S. #13594
December 1967 Consumers Power Company Section Break
Found 1½" Pipe in centerline of pavement
(2) 6" Twin Maple S60°W 71.0' #5
28" Elm N30°E 72.10' #3
28" Elm Stump S45°E 63.5' #4

Newaygo Engineering and Survey Company
September 29, 1979 Found 1¼" Pipe raised with ½" rod
8"-8" Twin Maple S65°W 71.48' #5
Centerline of street post N45°W 46.20' #6

Paul E. Van Kooten R.L.S. #8618
LCRC #503 November 1979
Found ½" Iron rod
9" Twin Maple Southwest 71.50' #5
Centerline street sign Northwest 46.00' #6