

SURVEY & REMONUMENTATION

MAR 19 1998

1997 Newaygo County Remonumentation Project

NEWAYGO COUNTY REGISTER OF DEEDS LINDA M. BROWN

SECTION

LAND CORNER RECORDATION CERTIFICATE FILING REQUIREMENT of Act 74, Mich. P.A. 1970

'98 MAR 6 PM 12 34

Linda M. Brown

Form with fields: For corners in Newaygo (County), Located in: T 11N R 14W, Corner Code # C-4, 1. Public Land Survey, 2. Property Controlling in Section, 3. Miscellaneous Property in Sec., 4. Lot No., 5. Private Claims

VOL. 2

58

Register of Deeds Stamp & File Number

Grid table with columns A-L and rows 1-13. Cell (4,8) contains a solid black circle.

I, Norman L. Ochs, in a field survey on March 31, 1997, do hereby certify that under requirements of P. A. 74, Michigan P.A. of 1970, the corner points mentioned in lines 1 and 2 above were in conformance with regulations and rules therefore as required in the current manual of survey instructions of the United States Department of the Interior, Bureau of Land Management or by a decree of a Court of Law and/or that the corner points mentioned in lines 3, 4 and 5 above were in conformance with the rules of the Michigan Board of Land Surveyors or by a Decree of a Court of Law; established, re-established, monumented, re-monumented, recovered, found as expressed below:

Note: Not more than 4 corners, all in the same town and range, may be recorded on this certificate.

West One Quarter Corner, Section 8, Bridgeton Township, Newaygo County, Michigan

A. DESCRIPTION OF ORIGINAL MONUMENT AND ACCESSORIES AND/OR SUBSEQUENT RESTORATION:

G.L.O. John Mullett 1837 12" Hemlock S39°W 33 Links (21.78')#1 6" Blue Beech S74°E 15 Links (9.90')#2

Lyle S. Shepherd R.L.S. #503 Witness Book Number 2 Page 136 10" Hickory N72½°E 103' #3

John C. Brewster (County Surveyor) Book A Page 6 June 30, 1875 Set in proportion as shown by plat. Stone with bottle on South side and plow point on North side. Bottle contains names of persons present and date of survey.

Patrick A. Salisbury R.L.S. #13594 December 1967 Consumers Power Company Section Break Found 1½" Pipe 16" Hickory N73°E 102.9' #3 Power Pole S20°E 105.9' #4

Newaygo County Road Commission Sheet 1½" Pipe 16" Hickory N73°E 102.95' #3 Power Pole S20°E 105.95' #4

Newaygo Engineering and Survey Company September 29, 1979 Recorded in Series K, Number 2530 Found 1½" Pipe 18" Hickory N73°E 103.23' #4 Power Pole S20°E 106.39' #4

OVER

B. DESCRIPTION OF CORNER EVIDENCE FOUND AND/OR METHOD APPLIED IN RESTORING OR REESTABLISHING CORNER:

Found ¾" Pipe 3' long, 18" deep. The centerline of dirt road going East is 2 feet South and in the centerline of bituminous road going North and South and the condition of the recorded witnesses are: #1 and #2 gone, #3 and #4 good condition.

C. DESCRIPTION OF MONUMENT FOR CORNER AND ACCESSORIES ESTABLISHED TO PERPETUATE LOCATING THE POSITION OF THE CORNER:

Removed ¾" Pipe and set a 4" diameter Harrison monument 20" long marked "County Surveyor" as a substantial marker for the section corner and is accepted as a careful and faithful reestablishment of the original corner.

28" Hickory N78°E 103.08' Found spike in South side of tree. #3 Power Pole S12°E 106.60' Found spike in West side of pole. #4 12" diameter Fence Post 5' above ground N85°W 285.83' Set P.K. nail with tag #22439 in top center. Phone Riser #10895 N04°W 183.24' Top center.

Signed by Norman L. Ochs


Date September 8, 1997

Surveyor's Michigan License No. 22439

Form approved by Michigan State Board of Land Surveyors, April 29, 1971

Approved by Peer Review Group on September 9, 1997 Norman L. Ochs, County Representative.

N.L.O.

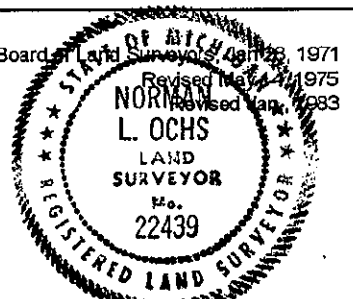

A. Description (cont.)

Paul E. Van Kooten R.L.S. #8618

November 1979 LCRC #503

Found 1/2" Round Iron

Power Pole South - Southeast 106.45' #4

14" Oak East - Northeast 103.20' #3 ,