

**SURVEY & REMONUMENTATION**

MAR 19 1998

1997 Newaygo County Remonumentation Project

NEWAYGO COUNTY REGISTER OF DEEDS LINDA M. BROWN

**LAND CORNER RECORDATION CERTIFICATE**  
FILING REQUIREMENT of Act 74, Mich. P.A. 1970

88 MAR 6 PM 12 34

**SECTION**

For corners in <u>Newaygo</u> (County)	Located in:	Corner Code #
1. Public Land Survey	T <u>11N</u> R <u>14W</u>	<u>C-5</u>
	T <u>   </u> R <u>   </u>	<u>   </u>
	T <u>   </u> R <u>   </u>	<u>   </u>
	T <u>   </u> R <u>   </u>	<u>   </u>
2. Property Controlling in Section	S <u>   </u> T <u>   </u> R <u>   </u>	<u>   </u>
	S <u>   </u> T <u>   </u> R <u>   </u>	<u>   </u>
3. Miscellaneous Property in Sec.	S <u>   </u> T <u>   </u> R <u>   </u>	<u>   </u>
	S <u>   </u> T <u>   </u> R <u>   </u>	<u>   </u>
4. Lot No. _____, Recorded Plat _____		
5. Private Claims _____		

*Linda M. Brown*

VOL. 2

59

Register of Deeds Stamp & File Number

	A	B	C	D	E	F	G	H	I	J	K	L	M
1													
2	6		5		4		3		2		1		
3													
4	7		8		9		10		11		12		
5													
6	18		17		16		15		14		13		
7													
8	19		20		21		22		23		24		
9													
10	30		29		28		27		26		25		
11													
12	31		32		33		34		35		36		
13													

I, Norman L. Ochs, in a field survey on July 22, 1997, do hereby certify that under requirements of P. A. 74, Michigan P.A. of 1970, the corner points mentioned in lines 1 and 2 above were in conformance with regulations and rules therefore as required in the current manual of survey instructions of the United States Department of the Interior, Bureau of Land Management or by a decree of a Court of Law and/or that the corner points mentioned in lines 3, 4 and 5 above were in conformance with the rules of the Michigan Board of Land Surveyors or by a Decree of a Court of Law; established, re-established, monumented, re-monumented, recovered, found as expressed below:

Note: Not more than 4 corners, all in the same town and range, may be recorded on this certificate.

Southwest Corner, Section 8, Bridgeton Township, Newaygo County, Michigan

**A. DESCRIPTION OF ORIGINAL MONUMENT AND ACCESSORIES AND/OR SUBSEQUENT RESTORATION:**

G.L.O. John Mullett 1837  
12" Beech N39°E 18 Links (11.88')#1  
20" Hemlock S27°W 30 Links (19.80')#2

Ralph A. Smith R.L.S. #3421  
1951 Book 81 Page 69 and Book 56 Page 46  
1½" Well Point and glass  
6" Butternut West 51.3' #5  
12" Cherry S60°E 65.7' #6  
Corner Fence Post South 23.1' #7

John C. Brewster (County Surveyor)  
Book A Page 6 June 30, 1875  
5" Beech S84°W 28½ links (18.81')#3  
6" Beech South 3¾ Links (2.48')#4

Patrick A. Salisbury R.L.S. #13594  
December 1967 Consumers Power Company Section Break  
Found 1¼" Pipe  
Northeast Corner Headwall S56°W 18.1' #8  
5" Cedar S55°E 26.2' #9  
8" Cherry N46°E 25.5' #10

OVER ↙

**B. DESCRIPTION OF CORNER EVIDENCE FOUND AND/OR METHOD APPLIED IN RESTORING OR REESTABLISHING CORNER:**

Found 1¼" Pipe at point of intersection of roads going North and East and there is a North and South culvert 20 feet West. There is a fence corner for fence going East and South (fence on ground) is 23.1 feet South of corner. The condition of the recorded witnesses are: #1 thru #5 gone, #6 good condition, #7 fallen and found remains, #8 thru #10 good condition, #11 fallen, #12 gone, #13 good condition.

**C. DESCRIPTION OF MONUMENT FOR CORNER AND ACCESSORIES ESTABLISHED TO PERPETUATE LOCATING THE POSITION OF THE CORNER:**

Removed 1¼" pipe and set a 4" diameter Harrison cast iron monument 36" long marked "County Surveyor" as a substantial marker for the section corner and is accepted as a careful and faithful reestablishment of the original corner.

27" Cherry S60°E 66.31' Set spike in South side of tree. #6  
Northeast Corner Headwall S58°W 18.3' #8  
14" Cedar S52°E 26.33' Found spike in Southwest side of tree. #9  
14" Cherry N50°E 25.72' Set spike in Southeast side of tree. #10  
28" Cottonwood N40°W 38.15' Found spike in East side of tree. #11

Signed by Norman L. Ochs Date September 8, 1997

Norman L. Ochs


Surveyor's Michigan License No. 22439

Form approved by Michigan State Board of Land Surveyors, Jan. 26, 1971

Revised May 14, 1975  
Revised Jan., 1983

Approved by Peer Review Group on September 9, 1997  
Norman L. Ochs, County Representative.

*N.L.O.*

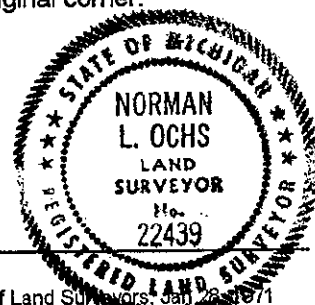

A. Description (cont.)

Steve Vallier R.L.S. #28428

1968 Found 1½" Pipe

6" Butternut West 51.3' #5

12" Cherry S60°E 65.7' #6

Northeast Corner Headwall S56°W 18.1' #8

5" Cedar S55°E 26.2' #9

8" Cherry N46°E 25.5' #10

Newaygo Engineering and Survey Company

August 13, 1979 Found 1¼" Pipe

15" Willow S50°E 19.25' #11

12" Cherry N44°E 25.55' #10

8" Cedar S65°E 26.45' #9

Paul E. Van Kooten R.L.S. #8618

LCRC #503 November 1979

Found 1½" Round Iron

10" Elm Southeast 19.21' #12

12" White Cherry Northeast 25.45' #10

18" Tree Northwest 38.32' #13

Newaygo Engineering and Survey Company

August 13, 1983 LCRC #598

Found 1½" Rod and 1½" Well Point

10" Elm Southeast 19.21' #12

12" Cherry Northeast 25.47' #10

18" Tree Northwest 38.32' #13

15" Willow S50°E 19.25' #11

8" Cedar S65°E 26.45' #9